


## 070024661

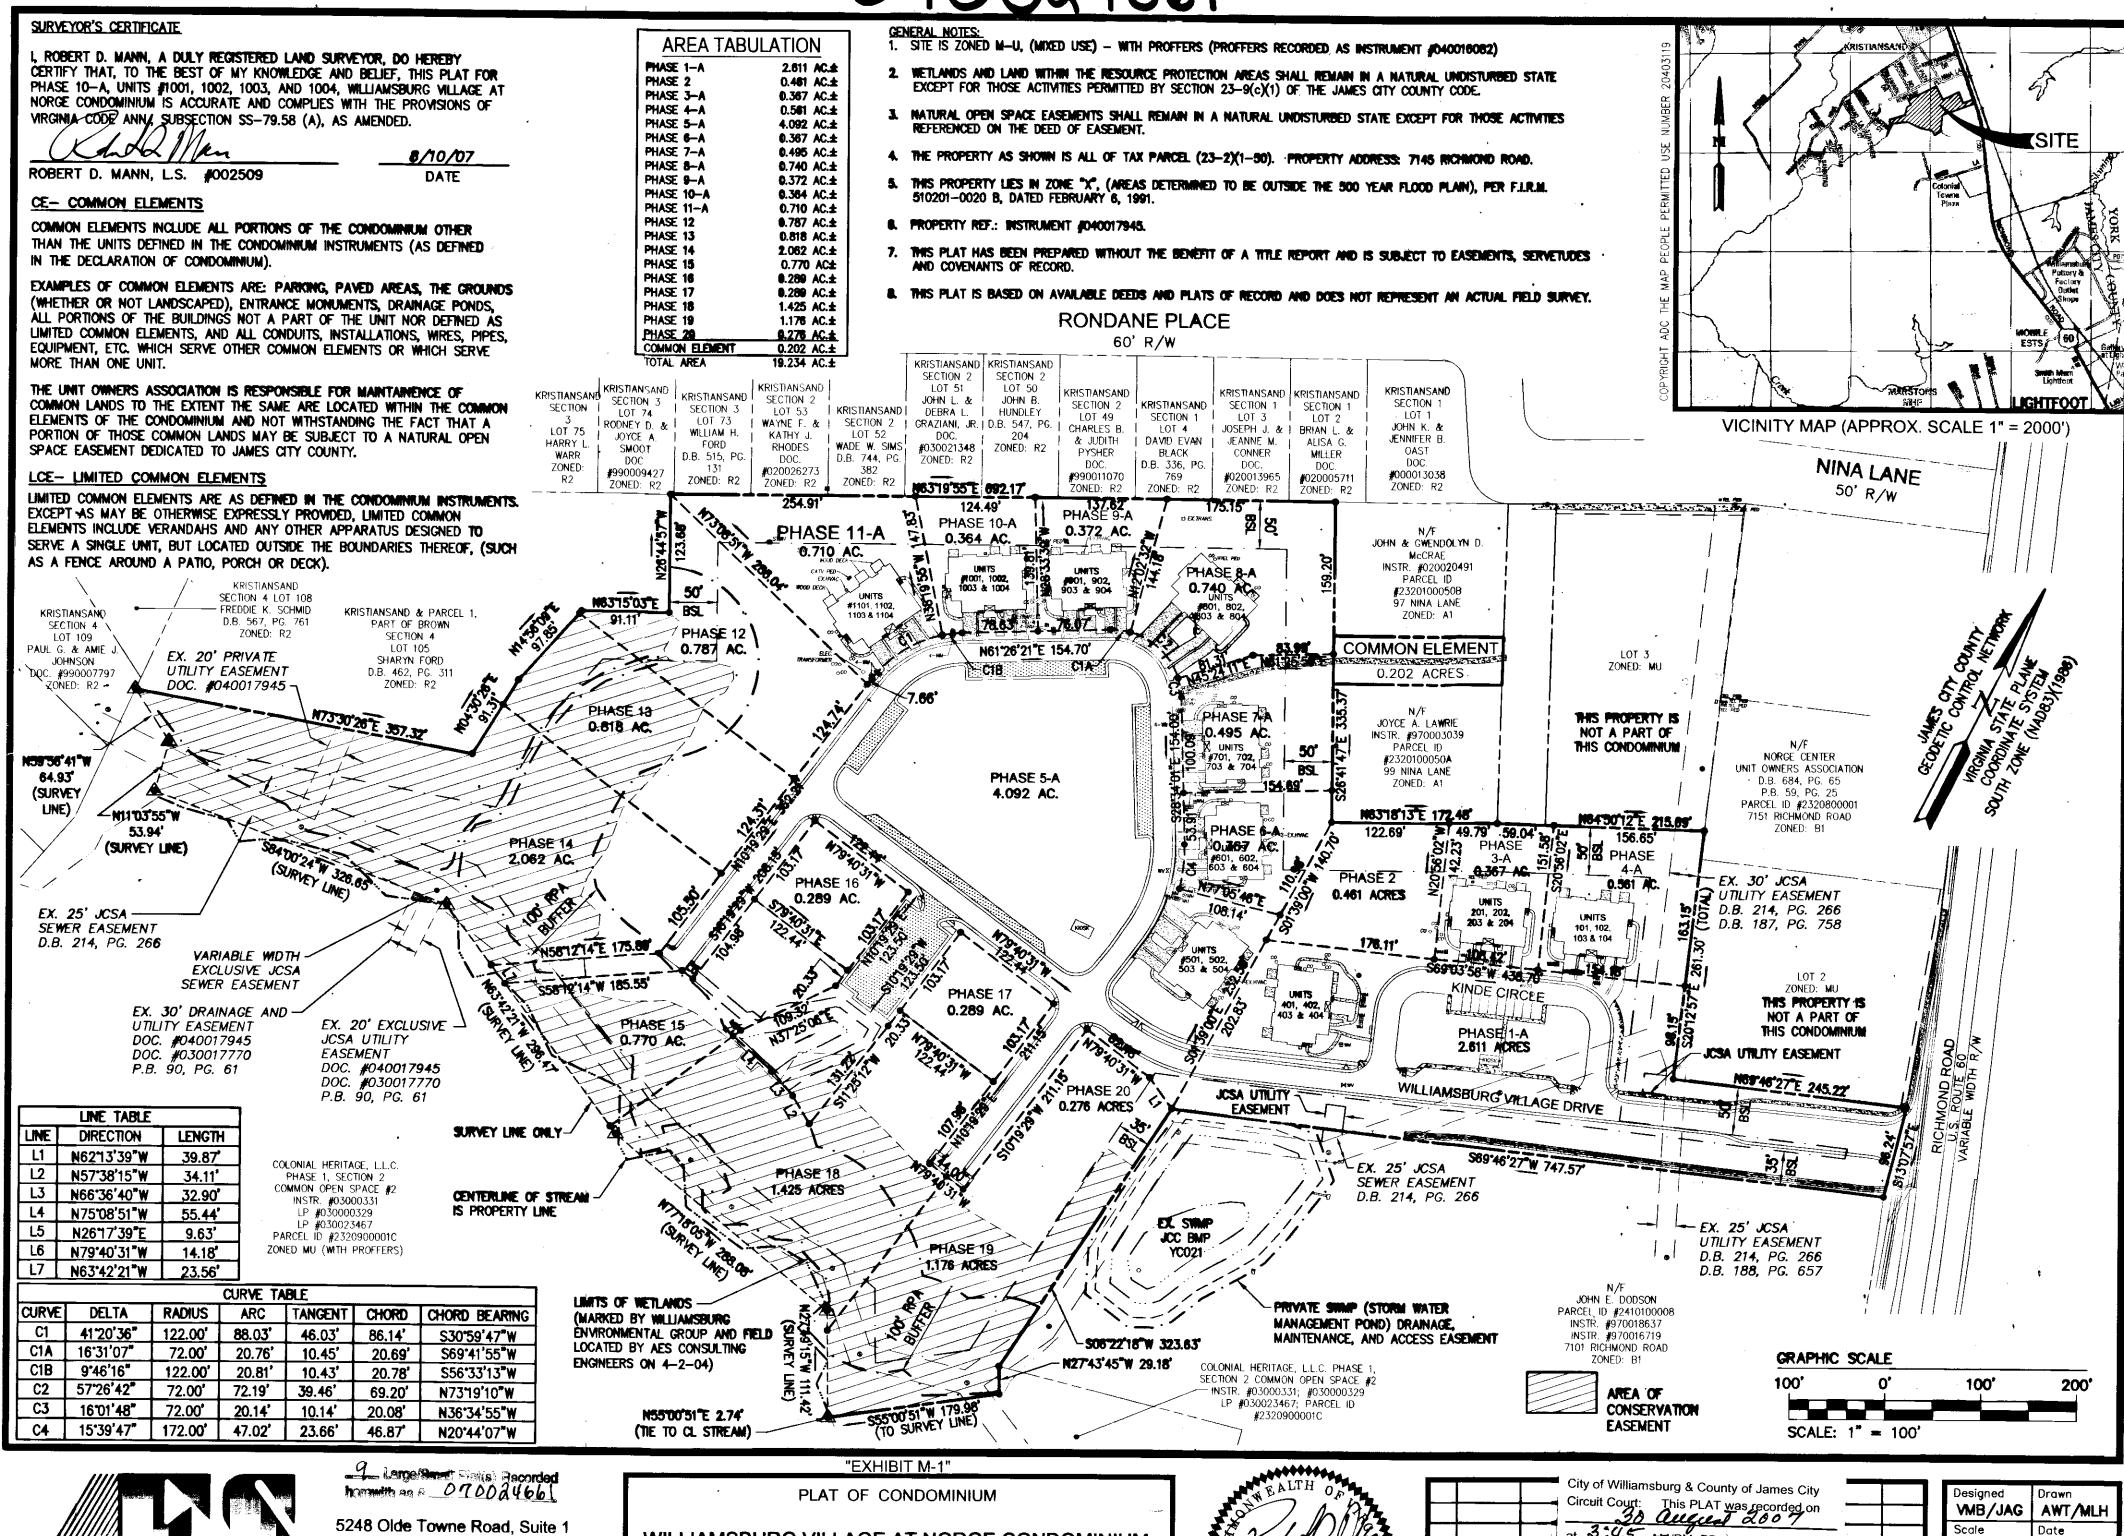


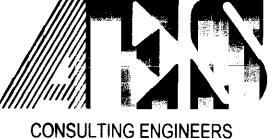

Williamsburg, Virginia 23188 (757) 253-0040 Fax (757) 220-8994

WILLIAMSBURG VILLAGE AT NORGE CONDOMINIUM PHASE 11-A UNITS #1101, 1102, 1103, AND 1104

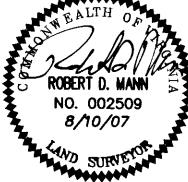

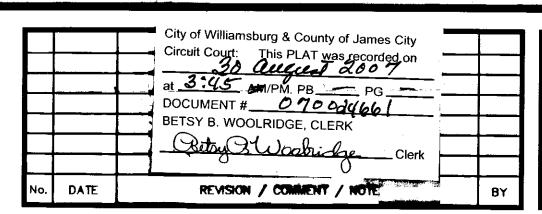

Date 1"=100' | 8/10/07 Project No. 9286 - 2Drawing No. 1 of 9

WILLIAMSBURG • RICHMOND • GLOUCESTER


STONEHOUSE DISTRICT

**COUNTY OF JAMES CITY** 


070024661 N6319'55"E 692.17' (TOTAL) 254.91 124.49 137.62 175.15 PHASE 11-A PHASE 9-A PHASE 10-A D EX.TRANS. 0.710 AC. 0.372 AC. WOOD DECK-PHASE 8-A EX. DWELLING UNITS JOHN & EX. DWELLING UNITS #901, 902, 903 & 904 EX.HVAC-GWENDOLYN D. McCRAE INSTR. #020020491 UNITS #1101, 1102, 1103 32,237 S.F. 0.740 AC. WOOD DECK & 1104 PARCEL ID UNITS #1101, 1102, 1103 & 1104 SEE INSET FOR DIMENSIONS #2320100050B EX. DWELLING 97 NINA LANE ZONED: A1 **3**.80 COMMON ELEC. TRANSFORMER ELEMENT N617559E 83.99 GRAVEL 0.202 AC. PHASE 12 N28'02'56"E---INSET - 1" = 20'0.787 AC. PHASE 7-A 0.495 AC. EX. DWELLING UNITS #701, 702, 703 & 704 N/F JOYCE A. LAWRIE INSTR. #970003039 PHASE 13 PHASE 5-A PARCEL ID LOT 3 #2320100050A 99 NINA LANE THIS PROPERTY IS NOT A PART 0.818 AC. ZONED: MU 4.092 AC. OF THIS CONDOMINIUM ZONED: A1 N631813E 172.48 PHASE 6-A N64'50'12"E 215.09" **49.79**′ 0.367 AC. PHASE 3-A PHASE 4-A 0.367 AC. EX. UNITS 0.561 AC. PHASE 14 PHASE 2 2.062 AC. PHASE 16 DEX.TRANS. OCO


WM BYMM

M770540 50 108 14 \_ cod \_ co 20,081 S.F. <sub>r</sub>0.461 AC. 0.289 AC. PHASE LINE KIOSK ONLY (TYP.) 75.89 EX. DWELLING UNITS \$501, 502, 503 & 504 08.42 \$6903'58 W 438.70'+ 185.55 EX.HVAC KINDE CIRCLE PHASE 17 EX. UNITS \$401, 402, 403, & 404 0.289 AC. PHASE 15 0.770 AC. PHASE 1-A 113,720 S.F. 2.611 AC. OPEN SPACE PHASE 18 WILLIAMSBURG VILLAGE PHASE 20 1.425 AC. 0.276 AC. **LEGEND** (CE) common element CO CLEAN OUT GRAPHIC SCALE WM III WATER METER PHASE 19 SANITARY MANHOLE FH - O- FIRE HYDRANT 1.176 AC. Large/Small Plat(s) Recorded WV WATER VALVE horowith as # 070024661 SCALE: 1" = 50'"EXHIBIT 1" PLAT OF CONDOMINIUM 5248 Olde Towne Road, Suite 1 WILLIAMSBURG VILLAGE AT NORGE CONDOMINIUM Williamsburg, Virginia 23188 (757) 253-0040 ROBERT D. MANÍN PHASE 11-A UNITS #1101, 1102, 1103, AND Fax (757) 220-8994 NO. 002509

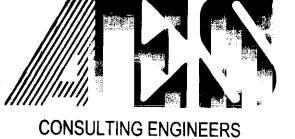


WILLIAMSBURG • RICHMOND • GLOUCESTER

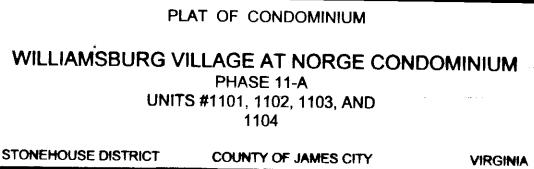

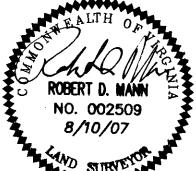

			_
		City of Williamsburg & County of James City	
		Circuit Court This PhAT was recorded on 30 lugar 2007	
		at 3:45 AM/PM PB - PG -	
		at 3:45 AM/PM. PB PG DOCUMENT # 0700 24661	
		BETSY B. WOOLRIDGE, CLERK	
		— Retry Woodridge Clerk	
	· ·	Clerk	
No.	DATE	REVISION / COMPANY / ART SERVICES	

	Designed VMB/JAG	Drawn AWT/MLH	
1	Scale	Date	
1	1"=50"	8/10/07	
1 1	Project No.		
	928	6-2	
	Drawing No.		
	2 c	of 9	

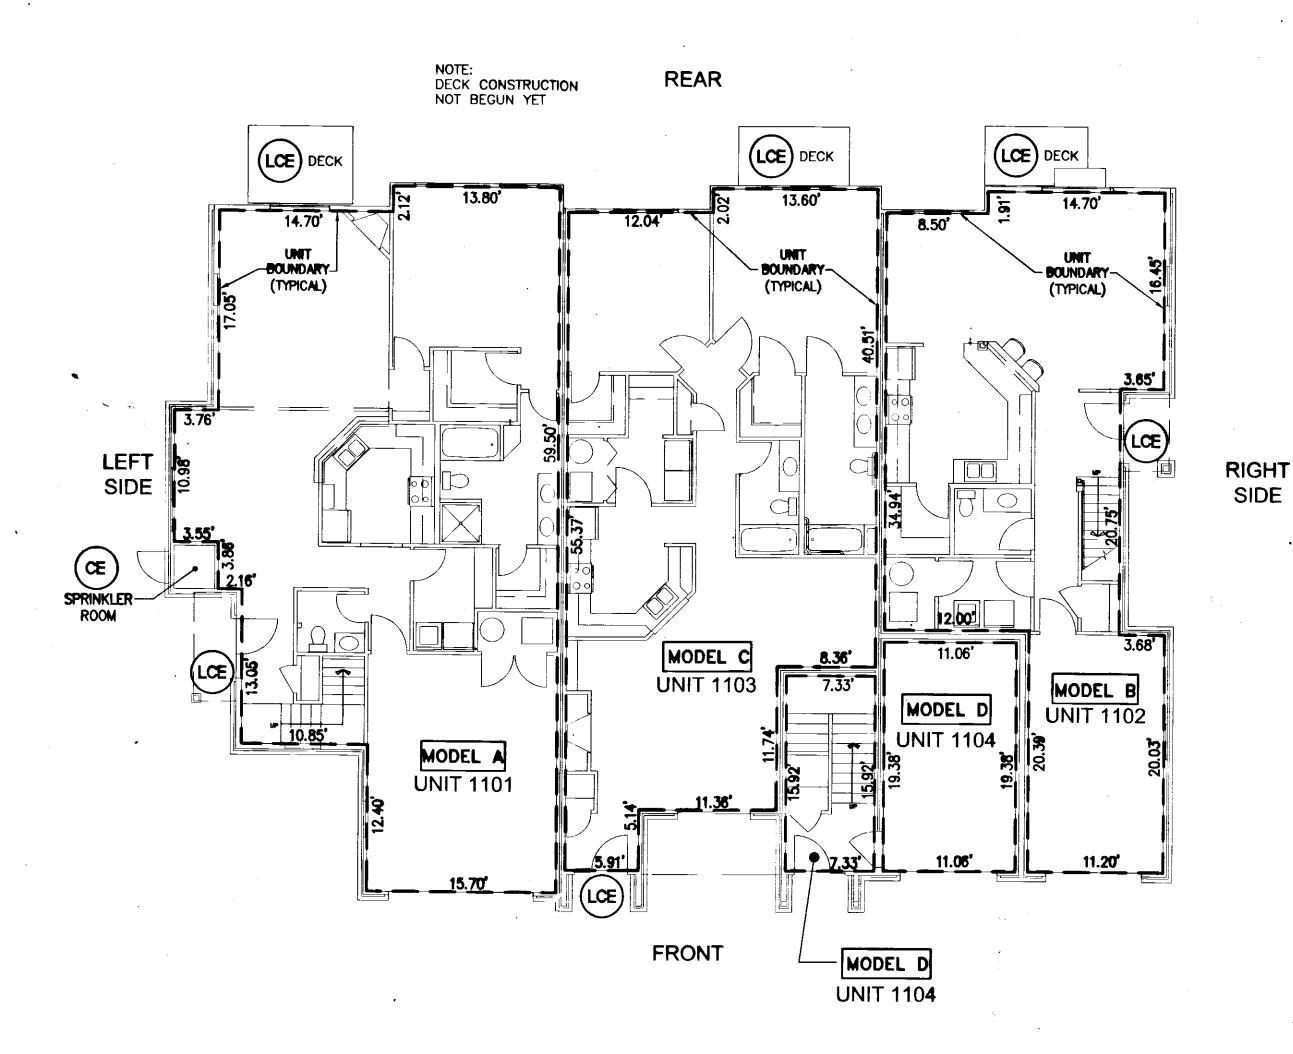

(CE) COMMON ELEMENT

(LCE) LIMITED COMMON ELEMENT

- - - UNIT BOUNDARY

NOTE

- 1. COMMON ELEMENTS, LIMITED COMMON ELEMENTS AND UNITS ARE SUBSTANTIALLY COMPLETE.
- 2. ALL BUILDING DIMENSIONS AND DETAILS SHOWN ARE PER ARCHITECTURAL PLANS PROVIDED TO AES CONSULTING ENGINEERS BY THE DEVELOPER.
- 3. THE LOWER (HORIZONTAL) BOUNDARY OF EACH UNIT AS SHOWN IN THE PLAN AS LOCATED ON PHASE I IS THE HORIZONTAL PLANE OF THE UPPER SURFACE OF THE CONCRETE FLOOR SLAB OF THOSE UNITS HAVING A FIRST FLOOR COMPONENT, AND IS THE HORIZONTAL PLANE OF THE UPPER SURFACE OF THE UNFINISHED FLOOR (TOP SURFACE OF THE PLYWOOD) FOR THOSE UNITS HAVING COMPONENTS ABOVE THE FIRST FLOOR.
- 4. FOR TWO-STORY UNITS, THE UPPER (HORIZONTAL) BOUNDARY IS THE PLANE OF THE LOWER SURFACE OF THE DRYWALL THAT IS THE CEILING OF THE SECOND FLOOR, OR ATTIC, OR STORAGE AREA ABOVE THE SECOND FLOOR. NONE OF THE ROOF WILL BE A PART OF THE UNIT. FOR ONE-STORY UNITS, THE UPPER BOUNDARY IS THE PLANE OF THE LOWER SURFACE OF THE DRYWALL THAT IS THE CEILING OF THE UNIT.
- 5. THE VERTICAL (SIDE) BOUNDARIES OF THE UNIT SHALL BE THE VERTICAL PLANE OF THE UNITINISHED INNER SURFACE OF THE DRYWALL ON THE INSIDE OF THE PERIMETER WALLS OF THE UNIT, EXTENDED TO INTERSECTIONS WITH EACH OTHER AND WITH THE UPPER AND LOWER BOUNDARIES. WHENEVER THERE IS AN OVERHANG CREATED BY A SECOND FLOOR EXTENDING OUT BEYOND THE VERTICAL PLANE OF THE EXTERIOR OF THE FIRST FLOOR, THE VERTICAL (SIDE) BOUNDARY OF THE FIRST FLOOR AND THE VERTICAL BOUNDARY OF THE SECOND FLOOR SHALL BE JOINED BY THE UPPER PLANE (INTERIOR) OF THE SOFFIT.
- 6. LOWER, UPPER AND SIDE BOUNDARIES ARE MORE FULLY DESCRIBED IN THE DECLARATION OF CONDOMINIUM.
- 7. THE INTERIOR WALLS AND ELEMENTS AS SHOWN HEREON WERE TAKEN DIRECTLY FROM ARCHITECTURAL DRAWINGS PROVIDED BY THE DEVELOPER AND ARE INTENDED FOR REFERENCE PURPOSES ONLY. INTERIOR WALLS AND ELEMENTS HAVE NOT BEEN FIELD VERIFIED. THE SURVEYOR MAKES NO GUARANTEES THAT UNIT INTERIORS ARE CONSTRUCTED AS SHOWN.

9 Large/Small Plat(s) Recorded herewith as # 07002466



FIRST FLOOR PLAN SCALE: 1/8" = 1'

MODELS A, B, C & D

CONSULTING ENGINEERS

WILLIAMSBURG • RICHMOND • GLOUCESTER

5248 Olde Towne Road, Suite 1 Williamsburg, Virginia 23188 (757) 253-0040 Fax (757) 220-8994 PLAN OF CONDOMINIUM

"EXHIBIT 1"

WILLIAMSBURG VILLAGE AT NORGE CONDOMINIUM PHASE 11-A

UNITS #1101, 1102, 1103, AND 1104

STONEHOUSE DISTRICT

COUNTY OF JAMES CITY

**VIRGINIA** 



No. DATE	REVISION / COMMENT / NOTE	
	DOCUMENT # 070024661 BETSY B. WOOLRIDGE, CLERK	
	City of Williamsburg & County of James City  Circuit Court: This PLAT was recorded on  at at	


Designed VMB/JAG AWT/MLH

Scale Date 8/10/07

Project No. 9286-2

Drawing No. 3 of 9

REAR

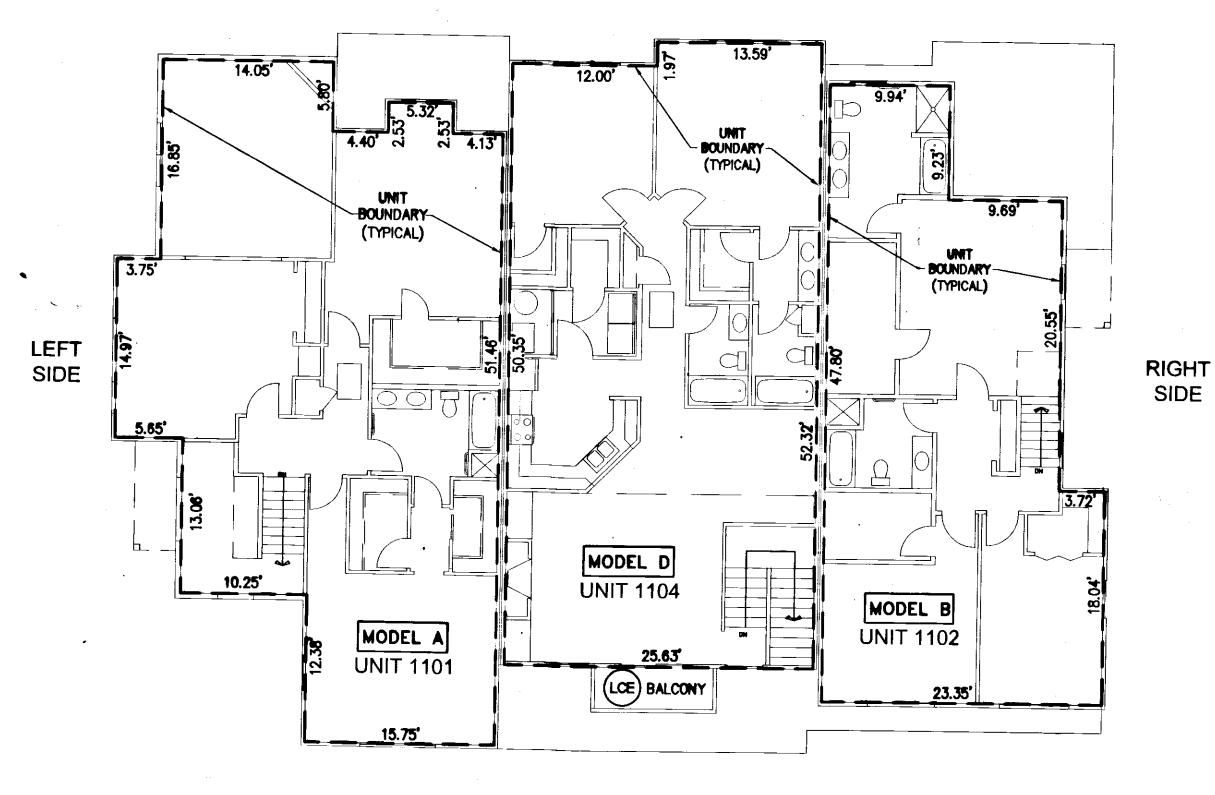

FRONT

SECOND FLOOR PLAN SCALE: 1/8" = 1'

MODELS A, B & D

Œ) co

COMMON ELEMENT




LIMITED COMMON ELEMENT

- - UNIT BOUNDARY

NOTES:

- 1. COMMON ELEMENTS, LIMITED COMMON ELEMENTS AND UNITS ARE SUBSTANTIALLY COMPLETE.
- 2. ALL BUILDING DIMENSIONS AND DETAILS SHOWN ARE PER ARCHITECTURAL PLANS PROVIDED TO AES CONSULTING ENGINEERS BY THE DEVELOPER.
- 3. THE LOWER (HORIZONTAL) BOUNDARY OF EACH UNIT AS SHOWN IN THE PLAN AS LOCATED ON PHASE I IS THE HORIZONTAL PLANE OF THE UPPER SURFACE OF THE CONCRETE FLOOR SLAB OF THOSE UNITS HAVING A FIRST FLOOR COMPONENT, AND IS THE HORIZONTAL PLANE OF THE UPPER SURFACE OF THE UNFINISHED FLOOR (TOP SURFACE OF THE PLYWOOD) FOR THOSE UNITS HAVING COMPONENTS ABOVE THE FIRST FLOOR.
- 4. FOR TWO-STORY UNITS, THE UPPER (HORIZONTAL) BOUNDARY IS THE PLANE OF THE LOWER SURFACE OF THE DRYWALL THAT IS THE CEILING OF THE SECOND FLOOR, OR ATTIC, OR STORAGE AREA ABOVE THE SECOND FLOOR. NONE OF THE ROOF WILL BE A PART OF THE UNIT. FOR ONE-STORY UNITS, THE UPPER BOUNDARY IS THE PLANE OF THE LOWER SURFACE OF THE DRYWALL THAT IS THE CEILING OF THE UNIT.
- 5. THE VERTICAL (SIDE) BOUNDARIES OF THE UNIT SHALL BE THE VERTICAL PLANE OF THE UNIFINISHED INNER SURFACE OF THE DRYWALL ON THE INSIDE OF THE PERIMETER WALLS OF THE UNIT, EXTENDED TO INTERSECTIONS WITH EACH OTHER AND WITH THE UPPER AND LOWER BOUNDARIES. WHENEVER THERE IS AN OVERHANG CREATED BY A SECOND FLOOR EXTENDING OUT BEYOND THE VERTICAL PLANE OF THE EXTERIOR OF THE FIRST FLOOR, THE VERTICAL (SIDE) BOUNDARY OF THE FIRST FLOOR AND THE VERTICAL BOUNDARY OF THE SECOND FLOOR SHALL BE JOINED BY THE UPPER PLANE (INTERIOR) OF THE SOFFIT.
- 6. LOWER, UPPER AND SIDE BOUNDARIES ARE MORE FULLY DESCRIBED IN THE DECLARATION OF CONDOMINIUM.
- 7. THE INTERIOR WALLS AND ELEMENTS AS SHOWN HEREON WERE TAKEN DIRECTLY FROM ARCHITECTURAL DRAWINGS PROVIDED BY THE DEVELOPER AND ARE INTENDED FOR REFERENCE PURPOSES ONLY. INTERIOR WALLS AND ELEMENTS HAVE NOT BEEN FIELD VERIFIED. THE SURVEYOR MAKES NO GUARANTEES THAT UNIT INTERIORS ARE CONSTRUCTED AS SHOWN.

1 Large/Small Plat(s) Recorded herewith as # 07002466

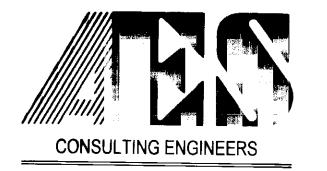

WILLIAMSBURG • RICHMOND • GLOUCESTER

5248 Olde Towne Road, Suite 1 Williamsburg, Virginia 23188 (757) 253-0040 Fax (757) 220-8994 "EXHIBIT 1"

PLAN OF CONDOMINIUM


WILLIAMSBURG VILLAGE AT NORGE CONDOMINIUM
PHASE 11-A

UNITS #1101, 1102, 1103, AND 1104

STONEHOUSE DISTRICT

COUNTY OF JAMES CITY

VIRGINIA

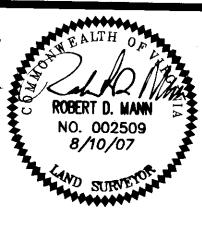


No. DATE	REVISION / COMMENT / NOTE	BY
	Retry Woodsibe Clerk	
	BETSY B. WOOLRIDGE, CLERK	
	DOCUMENT #	
<del></del>	at 3:45 AM/PM. PB PG	
	City of Williamsburg & County of James City  Circuit Court: This PLAT was recorded on	


Designed VMB/JAG AWT/MLH

Scale Date 8/10/07

Project No. 9286-2

Drawing No. 4 of 9

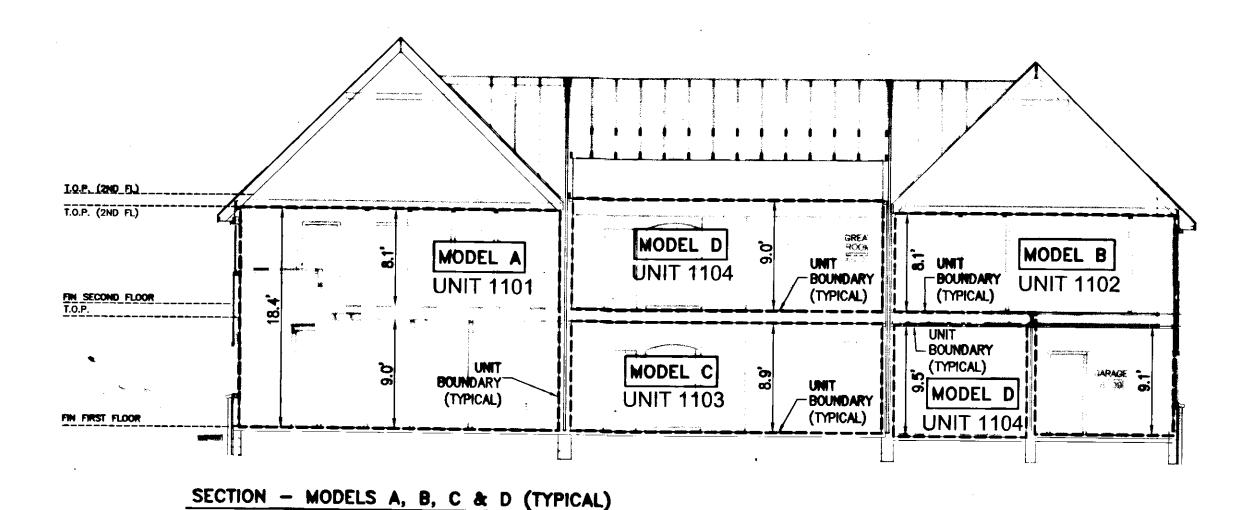

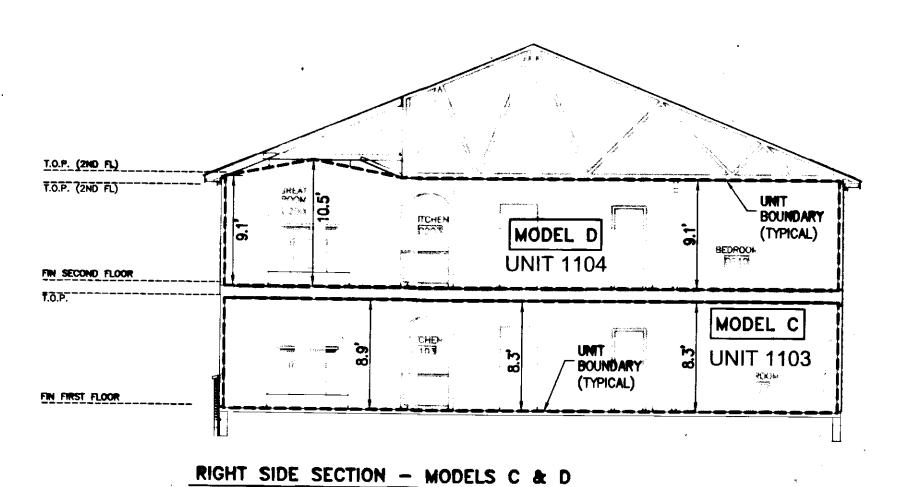

STONEHOUSE DISTRICT

(CE)

COMMON ELEMENT




LIMITED COMMON ELEMENT

---- UNIT BOUNDARY

#### NOTE

- 1. COMMON ELEMENTS, LIMITED COMMON ELEMENTS AND UNITS ARE SUBSTANTIALLY COMPLETE.
- 2. ALL BUILDING DIMENSIONS AND DETAILS SHOWN ARE PER ARCHITECTURAL PLANS PROVIDED TO AES CONSULTING ENGINEERS BY THE DEVELOPER.
- 3. THE LOWER (HORIZONTAL) BOUNDARY OF EACH UNIT AS SHOWN IN THE PLAN AS LOCATED ON PHASE I IS THE HORIZONTAL PLANE OF THE UPPER SURFACE OF THE CONCRETE FLOOR SLAB OF THOSE UNITS HAVING A FIRST FLOOR COMPONENT, AND IS THE HORIZONTAL PLANE OF THE UPPER SURFACE OF THE UNFINISHED FLOOR (TOP SURFACE OF THE PLYWOOD) FOR THOSE UNITS HAVING COMPONENTS ABOVE THE FIRST FLOOR.
- 4. FOR TWO-STORY UNITS, THE UPPER (HORIZONTAL) BOUNDARY IS THE PLANE OF THE LOWER SURFACE OF THE DRYWALL THAT IS THE CEILING OF THE SECOND FLOOR, OR ATTIC, OR STORAGE AREA ABOVE THE SECOND FLOOR. NONE OF THE ROOF WILL BE A PART OF THE UNIT. FOR ONE-STORY UNITS, THE UPPER BOUNDARY IS THE PLANE OF THE LOWER SURFACE OF THE DRYWALL THAT IS THE CEILING OF THE UNIT.
- 5. THE VERTICAL (SIDE) BOUNDARIES OF THE UNIT SHALL BE THE VERTICAL PLANE OF THE UNFINISHED INNER SURFACE OF THE DRYWALL ON THE INSIDE OF THE PERIMETER WALLS OF THE UNIT, EXTENDED TO INTERSECTIONS WITH EACH OTHER AND WITH THE UPPER AND LOWER BOUNDARIES. WHENEVER THERE IS AN OVERHANG CREATED BY A SECOND FLOOR EXTENDING OUT BEYOND THE VERTICAL PLANE OF THE EXTERIOR OF THE FIRST FLOOR, THE VERTICAL (SIDE) BOUNDARY OF THE FIRST FLOOR AND THE VERTICAL BOUNDARY OF THE SECOND FLOOR SHALL BE JOINED BY THE UPPER PLANE (INTERIOR) OF THE SOFFIT.
- 6. LOWER, UPPER AND SIDE BOUNDARIES ARE MORE FULLY DESCRIBED IN THE DECLARATION OF CONDOMINIUM.
- 7. THE INTERIOR WALLS AND ELEMENTS AS SHOWN HEREON WERE TAKEN DIRECTLY FROM ARCHITECTURAL DRAWINGS PROVIDED BY THE DEVELOPER AND ARE INTENDED FOR REFERENCE PURPOSES ONLY. INTERIOR WALLS AND ELEMENTS HAVE NOT BEEN FIELD VERIFIED. THE SURVEYOR MAKES NO GUARANTEES THAT UNIT INTERIORS ARE CONSTRUCTED AS SHOWN.

Percent 45 # 070024Lelo

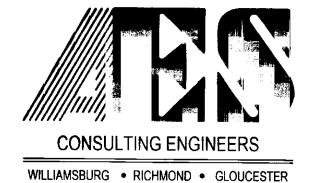

1/8" = 1'-0"

**5248 Olde Towne Road, Suite 1** Williamsburg, Virginia 23188 (757) 253-0040 Fax (757) 220-8994

"EXHIBIT 1"


PLAN OF CONDOMINIUM

WILLIAMSBURG VILLAGE AT NORGE CONDOMINIUM

PHASE 11-A


UNITS #1101, 1102, 1103, AND 1104


**COUNTY OF JAMES CITY** 

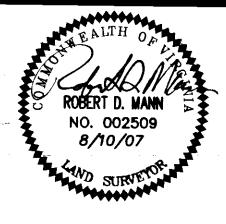

		City of Williamsburg & County of James City Circuit Court: This PLAT was recorded on  at 3:45 AM/PM PB PG  DOCUMENT # 070034661  BETSY B. WOOLRIDGE, CLERK	
No.	DATE	REVISION / COMMENT / NOTE	BY

Designed VMB/JAG	Drawn AWT/MLH		
Scale	Date		
1/8"=1"	8/10/07		
Project No.			
9286-2			
Drawing No.			
5 c	of 9		

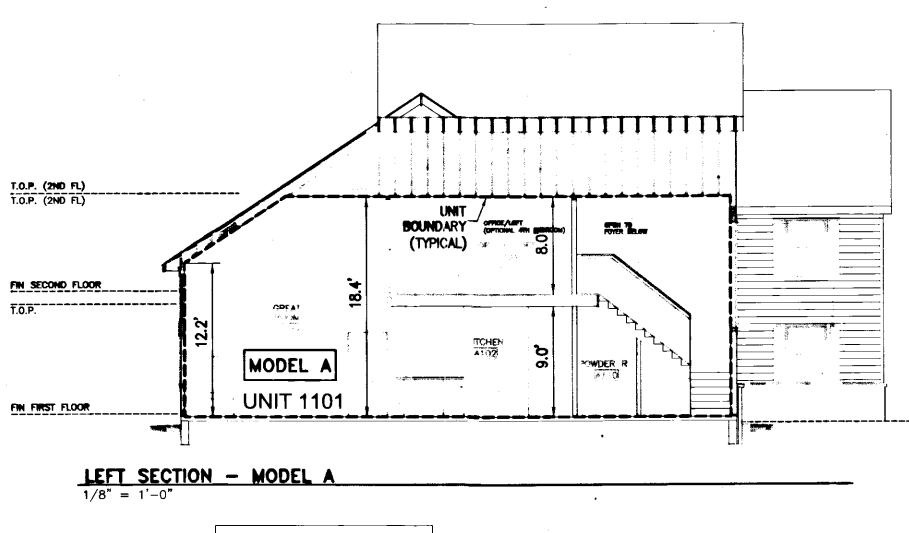

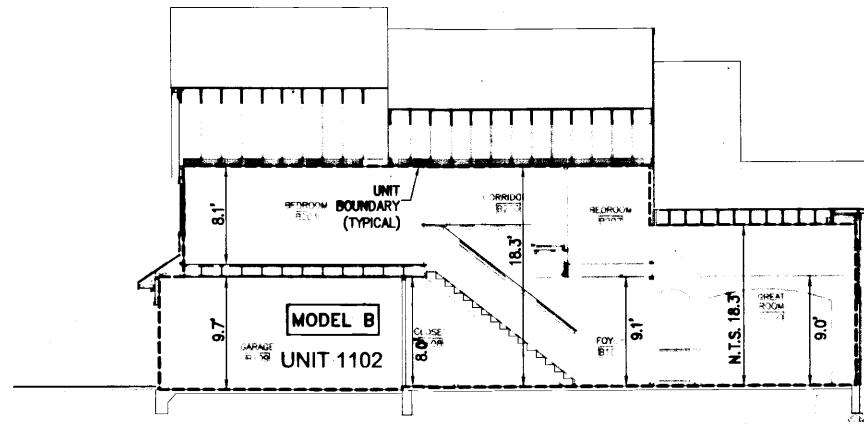

RIGHT SECTION - MODEL B

1/8" = 1'-0"

### 070024661

(CE)

COMMON ELEMENT



LIMITED COMMON ELEMENT

---- UNIT BOUNDAR

N.T.S. NOT TO SCALE

#### NOTES:

- 1. COMMON ELEMENTS, LIMITED COMMON ELEMENTS AND UNITS ARE SUBSTANTIALLY COMPLETE.
- 2. ALL BUILDING DIMENSIONS AND DETAILS SHOWN ARE PER ARCHITECTURAL PLANS PROVIDED TO 'AES CONSULTING ENGINEERS BY THE DEVELOPER.
- 3. THE LOWER (HORIZONTAL) BOUNDARY OF EACH UNIT AS SHOWN IN THE PLAN AS LOCATED ON PHASE I IS THE HORIZONTAL PLANE OF THE UPPER SURFACE OF THE CONCRETE FLOOR SLAB OF THOSE UNITS HAVING A FIRST FLOOR COMPONENT, AND IS THE HORIZONTAL PLANE OF THE UPPER SURFACE OF THE UNFINISHED FLOOR (TOP SURFACE OF THE PLYWOOD) FOR THOSE UNITS HAVING COMPONENTS ABOVE THE FIRST FLOOR.
- 4. FOR TWO-STORY UNITS, THE UPPER (HORIZONTAL) BOUNDARY IS THE PLANE OF THE LOWER SURFACE OF THE DRYWALL THAT IS THE CEILING OF THE SECOND FLOOR, OR ATTIC, OR STORAGE AREA ABOVE THE SECOND FLOOR. NONE OF THE ROOF WILL BE A PART OF THE UNIT. FOR ONE-STORY UNITS, THE UPPER BOUNDARY IS THE PLANE OF THE LOWER SURFACE OF THE DRYWALL THAT IS THE CEILING OF THE UNIT.
- 5. THE VERTICAL (SIDE) BOUNDARIES OF THE UNIT SHALL BE THE VERTICAL PLANE OF THE UNFINISHED INNER SURFACE OF THE DRYWALL ON THE INSIDE OF THE PERIMETER WALLS OF THE UNIT, EXTENDED TO INTERSECTIONS WITH EACH OTHER AND WITH THE UPPER AND LOWER BOUNDARIES. WHENEVER THERE IS AN OVERHANG CREATED BY A SECOND FLOOR EXTENDING OUT BEYOND THE VERTICAL PLANE OF THE EXTERIOR OF THE FIRST FLOOR, THE VERTICAL (SIDE) BOUNDARY OF THE FIRST FLOOR AND THE VERTICAL BOUNDARY OF THE SECOND FLOOR SHALL BE JOINED BY THE UPPER PLANE (INTERIOR) OF THE SOFFIT.
- 6. LOWER, UPPER AND SIDE BOUNDARIES ARE MORE FULLY DESCRIBED IN THE DECLARATION OF CONDOMINIUM.
- 7. THE INTERIOR WALLS AND ELEMENTS AS SHOWN HEREON WERE TAKEN DIRECTLY FROM ARCHITECTURAL DRAWINGS PROVIDED BY THE DEVELOPER AND ARE INTENDED FOR REFERENCE PURPOSES ONLY. INTERIOR WALLS AND ELEMENTS HAVE NOT BEEN FIELD VERIFIED. THE SURVEYOR MAKES NO GUARANTEES THAT UNIT INTERIORS ARE CONSTRUCTED AS SHOWN.

Arge/Small Plat(s) Recorded herowith as # 070024661



5248 Olde Towne Road, Suite 1 Williamsburg, Virginia 23188 (757) 253-0040 Fax (757) 220-8994 PLAN OF CONDOMINIUM


WILLIAMSBURG VILLAGE AT NORGE CONDOMINIUM

PHASE 11-A

UNITS #1101, 1102, 1103, AND 1104


STONEHOUSE DISTRICT COUNTY OF JAMES CITY VIRGINIA

"EXHIBIT 1"

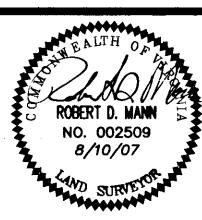

No.	DATE	REVISION / COMMENT / NOTE	BY
		Ritsy & Woodridge Clerk	
		BETSY B. WOOLRIDGE, CLERK	
╗		at _3:45 AM/PM PB PG DOCUMENT #_ 0 70024661	
_		Circuit Court: This PLAT was recorded on	
		City of Williamsburg & County of James City	

Designed VMB/JAG	Drawn AWT/MLH		
Scale	Date		
1/8"=1"	8/10/07		
Project No.			
9286-2			
Drawing No.			
6 of 9			

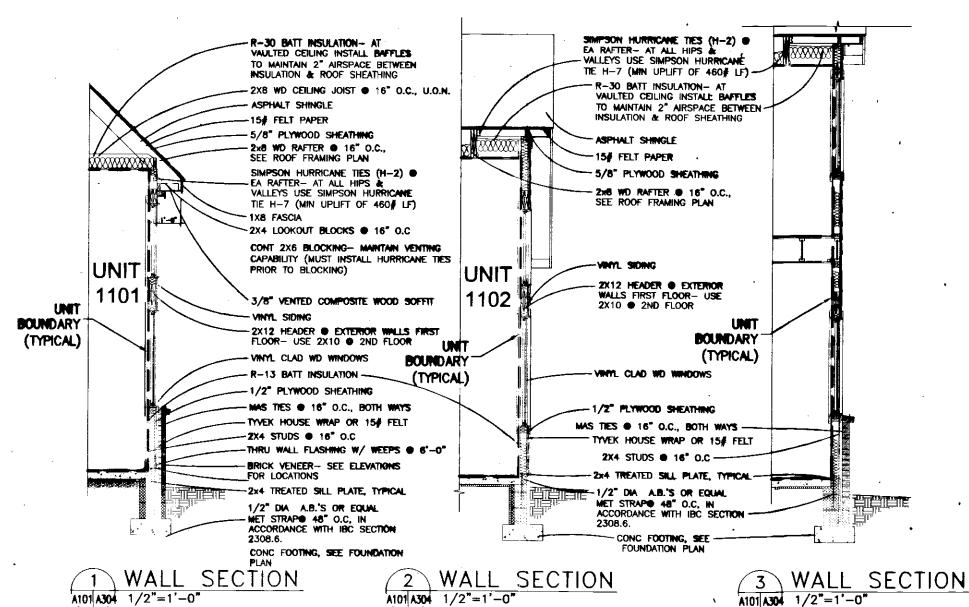

070024661


(CE)

COMMON ELEMENT

(LCE)

LIMITED COMMON ELEMENT

---- UNIT BOUNDARY

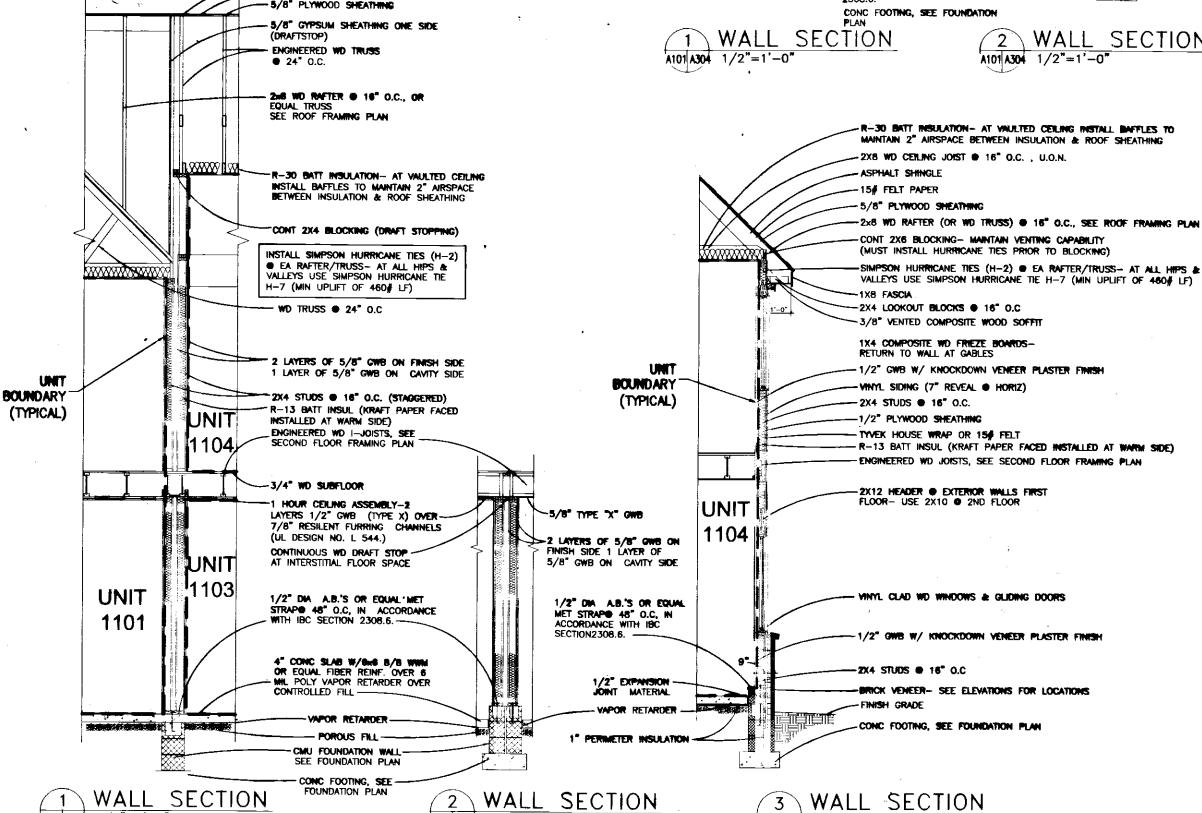

#### NOTES:

- 1. COMMON ELEMENTS, LIMITED COMMON ELEMENTS AND UNITS ARE SUBSTANTIALLY COMPLETE.
- 2. ALL BUILDING DIMENSIONS AND DETAILS SHOWN ARE PER ARCHITECTURAL PLANS PROVIDED TO AES CONSULTING ENGINEERS BY THE DEVELOPER.
- 3. THE LOWER (HORIZONTAL) BOUNDARY OF EACH UNIT AS SHOWN IN THE PLAN AS LOCATED ON PHASE I IS THE HORIZONTAL PLANE OF THE UPPER SURFACE OF THE CONCRETE FLOOR SLAB OF THOSE UNITS HAVING A FIRST FLOOR COMPONENT, AND IS THE HORIZONTAL PLANE OF THE UPPER SURFACE OF THE UNFINISHED FLOOR (TOP SURFACE OF THE PLYWOOD) FOR THOSE UNITS HAVING COMPONENTS ABOVE THE FIRST FLOOR.
- 4. FOR TWO-STORY UNITS, THE UPPER (HORIZONTAL) BOUNDARY IS THE PLANE OF THE LOWER SURFACE OF THE DRYWALL THAT IS THE CEILING OF THE SECOND FLOOR, OR ATTIC, OR STORAGE AREA ABOVE THE SECOND FLOOR. NONE OF THE ROOF WILL BE A PART OF THE UNIT. FOR ONE-STORY UNITS, THE UPPER BOUNDARY IS THE PLANE OF THE LOWER SURFACE OF THE DRYWALL THAT IS THE CEILING OF THE UNIT.
- 5. THE VERTICAL (SIDE) BOUNDARIES OF THE UNIT SHALL BE THE VERTICAL PLANE OF THE UNFINISHED INNER SURFACE OF THE DRYWALL ON THE INSIDE OF THE PERIMETER WALLS OF THE UNIT, EXTENDED TO INTERSECTIONS WITH EACH OTHER AND WITH THE UPPER AND LOWER BOUNDARIES. WHENEVER THERE IS AN OVERHANG CREATED BY A SECOND FLOOR EXTENDING OUT BEYOND THE VERTICAL PLANE OF THE EXTERIOR OF THE FIRST FLOOR, THE VERTICAL (SIDE) BOUNDARY OF THE FIRST FLOOR AND THE VERTICAL BOUNDARY OF THE SECOND FLOOR SHALL BE JOINED BY THE UPPER PLANE (INTERIOR) OF THE SOFFIT.
- 6. LOWER, UPPER AND SIDE BOUNDARIES ARE MORE FULLY DESCRIBED IN THE DECLARATION OF CONDOMINIUM.
- 7. THE WALL SECTIONS AS SHOWN HEREON WERE TAKEN FROM ARCHITECTURAL DRAWINGS PROVIDED BY THE DEVELOPER. THE INTENDED PURPOSE IS TO ILLUSTRATE TYPICAL UNIT BOUNDARIES ONLY. ALL OTHER INFORMATION INCLUDING CONSTRUCTION MATERIALS AND METHODS IS SHOWN FOR REFERENCE PURPOSES ONLY AND HAS NOT BEEN FIELD VERIFIED. THE SURVEYOR MAKES NO GUARANTEES AS TO BUILDING METHODS, MATERIALS, OR CONSTRUCTION.

"EXHIBIT 1"

A101 A303 1/2"=1'-0"

PLAN OF CONDOMINIUM


WILLIAMSBURG VILLAGE AT NORGE CONDOMINIUM

PHASE 11-A UNITS #1101, 1102, 1103, AND 1104

STONEHOUSE DISTRICT

**COUNTY OF JAMES CITY** 


VIRGINIA

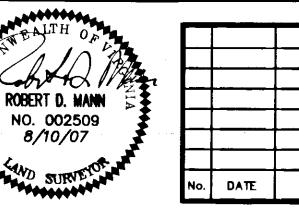

Large/Smail Plat(s) Recorded

REVISION / COMMENT / NOTE	BY
0	
Retry Wooking Clerk	
BETSY B. WOOLRIDGE, CLERK	
DOCUMENT #	
at 3:45 AM/PM. PB PG	
at 3.45 AM/PM. PB PG	
City of Williamsburg & County of James City	
City of Williamsburg & County of Issue Or	

Designed Drawn
WMB/JAG AWT/MLH
Scale Date
1/2"=1' 8/10/07
Project No.
9286-2
Drawing No.
7 of 9

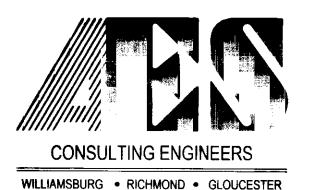


A101 A303 1/2"=1'-0"

5248 Olde Towne Road, Suite 1 Williamsburg, Virginia 23188 (757) 253-0040 Fax (757) 220-8994

A101 A303 1/2"=1'-0"

·**ASPHA**LT **SHINGLE** -15∦ FELT PAPER

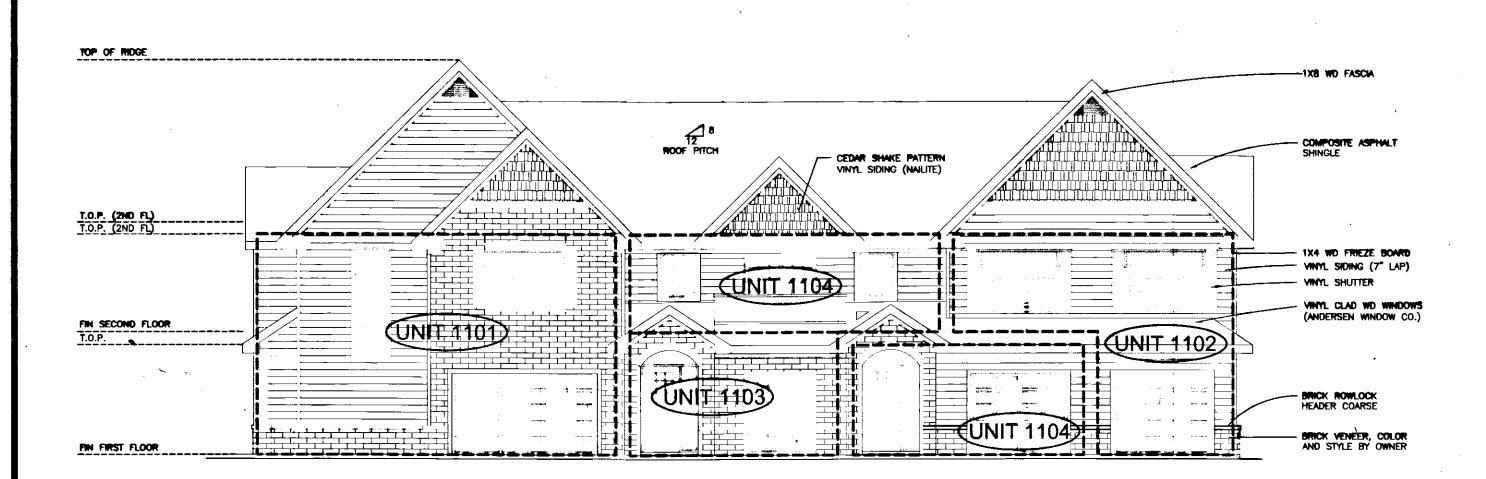

T.O.P. (2NO FL)

T.O.P. (2NO FL)

FIN SECOND FLOOR

T.O.P.

PNC COMPOSITE COLUMN

RIGHT SIDE ELEVATION- MODEL B (UNIT 1102)

STONEHOUSE DISTRICT

### 0700 a4661

(CE)

COMMON ELEMENT




LIMITED COMMON ELEMENT

---- UNIT BOUNDARY

#### NOTES

- 1. COMMON ELEMENTS, LIMITED COMMON ELEMENTS AND UNITS ARE SUBSTANTIALLY COMPLETE.
- 2. ALL BUILDING DIMENSIONS AND DETAILS SHOWN ARE PER ARCHITECTURAL PLANS PROVIDED TO AES CONSULTING ENGINEERS BY THE DEVELOPER.
- 3. THE LOWER (HORIZONTAL) BOUNDARY OF EACH UNIT AS SHOWN IN THE PLAN AS LOCATED ON PHASE I IS THE HORIZONTAL PLANE OF THE UPPER SURFACE OF THE CONCRETE FLOOR SLAB OF THOSE UNITS HAVING A FIRST FLOOR COMPONENT, AND IS THE HORIZONTAL PLANE OF THE UPPER SURFACE OF THE UNFINISHED FLOOR (TOP SURFACE OF THE PLYWOOD) FOR THOSE UNITS HAVING COMPONENTS ABOVE THE FIRST FLOOR.
- 4. FOR TWO-STORY UNITS, THE UPPER (HORIZONTAL) BOUNDARY IS THE PLANE OF THE LOWER SURFACE OF THE DRYWALL THAT IS THE CEILING OF THE SECOND FLOOR, OR ATTIC, OR STORAGE AREA ABOVE THE SECOND FLOOR. NONE OF THE ROOF WILL BE A PART OF THE UNIT. FOR ONE-STORY UNITS, THE UPPER BOUNDARY IS THE PLANE OF THE LOWER SURFACE OF THE DRYWALL THAT IS THE CEILING OF THE UNIT.
- 5. THE VERTICAL (SIDE) BOUNDARIES OF THE UNIT SHALL BE THE VERTICAL PLANE OF THE UNITINISHED INNER SURFACE OF THE DRYWALL ON THE INSIDE OF THE PERIMETER WALLS OF THE UNIT, EXTENDED TO INTERSECTIONS WITH EACH OTHER AND WITH THE UPPER AND LOWER BOUNDARIES. WHENEVER THERE IS AN OVERHANG CREATED BY A SECOND FLOOR EXTENDING OUT BEYOND THE VERTICAL PLANE OF THE EXTERIOR OF THE FIRST FLOOR, THE VERTICAL (SIDE) BOUNDARY OF THE FIRST FLOOR AND THE VERTICAL BOUNDARY OF THE SECOND FLOOR SHALL BE JOINED BY THE UPPER PLANE (INTERIOR) OF THE SOFFIT.
- 6. LOWER, UPPER AND SIDE BOUNDARIES ARE MORE FULLY DESCRIBED IN THE DECLARATION OF CONDOMINIUM.
- 7. THE WALL SECTIONS AS SHOWN HEREON WERE TAKEN FROM ARCHITECTURAL DRAWINGS PROVIDED BY THE DEVELOPER. THE INTENDED PURPOSE IS TO ILLUSTRATE TYPICAL UNIT BOUNDARIES ONLY. ALL OTHER INFORMATION INCLUDING CONSTRUCTION MATERIALS AND METHODS IS SHOWN FOR REFERENCE PURPOSES ONLY AND HAS NOT BEEN FIELD VERIFIED. THE SURVEYOR MAKES NO GUARANTEES AS TO BUILDING METHODS, MATERIALS, OR CONSTRUCTION.

Plants Recorded Plants Recorded Plants Plants Recorded Plants

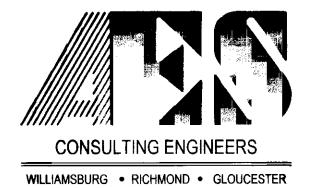

5248 Olde Towne Road, Suite 1 Williamsburg, Virginia 23188 (757) 253-0040 Fax (757) 220-8994

1/8" = 1'-0"

FRONT ELEVATION

"EXHIBIT 1"


PLAN OF CONDOMINIUM

WILLIAMSBURG VILLAGE AT NORGE CONDOMINIUM

PHASE 11-A

UNITS #1101, 1102, 1103, AND 1104

**COUNTY OF JAMES CITY** 

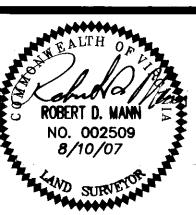

No. DATE	REVISION / COMMENT / NOTE	BY
	Clerk	+-
	Ritar Wooding Clerk	
<del>                                     </del>	BETSY B. WOOLRIDGE, CLERK	
	- DOCUMENT # 070004661	
<del> </del>	at 3:45 PM AMARINE PB PG DOCUMENT # 070034661	
	Circuit Court: This PLAT was recorded on	+-
	City of Williamsburg & County of James City	

Designed VMB/JAG	Drawn AWT/MLH	
Scale	Date	
1/8"=1"	8/10/07	
Project No.		
9286-2		
Drawing No.		
8 0	of 9	

# 070024661


(CE)

COMMON ELEMENT




LIMITED COMMON ELEMENT

---- UNIT BOUNDARY

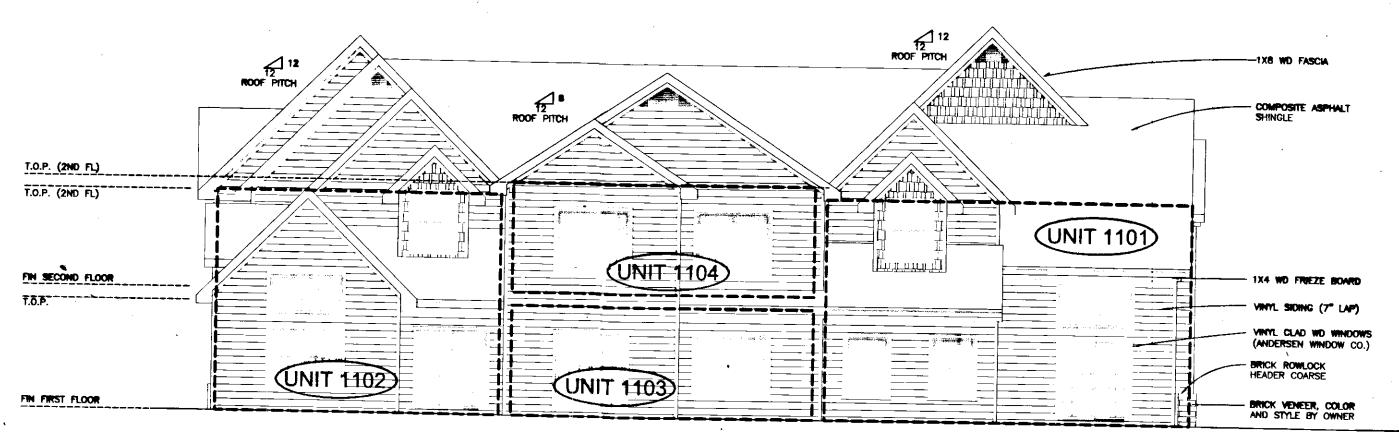

REAR ELEVATION

1/8" = 1'-0

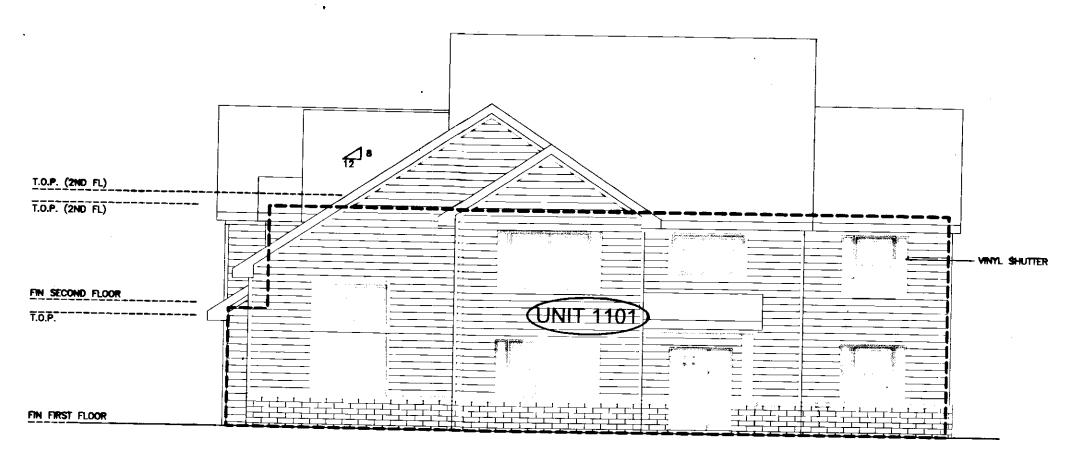


LEFT SIDE ELEVATION- MODEL A (UNIT 1101)

#### NOTES:

- 1. COMMON ELEMENTS, LIMITED COMMON ELEMENTS AND UNITS ARE SUBSTANTIALLY COMPLETE.
- 2. ALL BUILDING DIMENSIONS AND DETAILS SHOWN ARE PER ARCHITECTURAL PLANS PROVIDED TO AES CONSULTING ENGINEERS BY THE DEVELOPER.
- 3. THE LOWER (HORIZONTAL) BOUNDARY OF EACH UNIT AS SHOWN IN THE PLAN AS LOCATED ON PHASE I IS THE HORIZONTAL PLANE OF THE UPPER SURFACE OF THE CONCRETE FLOOR SLAB OF THOSE UNITS HAVING A FIRST FLOOR COMPONENT, AND IS THE HORIZONTAL PLANE OF THE UPPER SURFACE OF THE UNFINISHED FLOOR (TOP SURFACE OF THE PLYWOOD) FOR THOSE UNITS HAVING COMPONENTS ABOVE THE FIRST FLOOR.
- 4. FOR TWO-STORY UNITS, THE UPPER (HORIZONTAL) BOUNDARY IS THE PLANE OF THE LOWER SURFACE OF THE DRYWALL THAT IS THE CEILING OF THE SECOND FLOOR, OR ATTIC, OR STORAGE AREA ABOVE THE SECOND FLOOR. NONE OF THE ROOF WILL BE A PART OF THE UNIT. FOR ONE-STORY UNITS, THE UPPER BOUNDARY IS THE PLANE OF THE LOWER SURFACE OF THE DRYWALL THAT IS THE CEILING OF THE UNIT.
- 5. THE VERTICAL (SIDE) BOUNDARIES OF THE UNIT SHALL BE THE VERTICAL PLANE OF THE UNFINISHED INNER SURFACE OF THE DRYWALL ON THE INSIDE OF THE PERIMETER WALLS OF THE UNIT, EXTENDED TO INTERSECTIONS WITH EACH OTHER AND WITH THE UPPER AND LOWER BOUNDARIES. WHENEVER THERE IS AN OVERHANG CREATED BY A SECOND FLOOR EXTENDING OUT BEYOND THE VERTICAL PLANE OF THE EXTERIOR OF THE FIRST FLOOR, THE VERTICAL (SIDE) BOUNDARY OF THE FIRST FLOOR AND THE VERTICAL BOUNDARY OF THE SECOND FLOOR SHALL BE JOINED BY THE UPPER PLANE (INTERIOR) OF THE SOFFIT.
- 6. LOWER, UPPER AND SIDE BOUNDARIES ARE MORE FULLY DESCRIBED IN THE DECLARATION OF CONDOMINIUM.
- 7. THE WALL SECTIONS AS SHOWN HEREON WERE TAKEN FROM ARCHITECTURAL DRAWINGS PROVIDED BY THE DEVELOPER. THE INTENDED PURPOSE IS TO ILLUSTRATE TYPICAL UNIT BOUNDARIES ONLY. ALL OTHER INFORMATION INCLUDING CONSTRUCTION MATERIALS AND METHODS IS SHOWN FOR REFERENCE PURPOSES ONLY AND HAS NOT BEEN FIELD VERIFIED. THE SURVEYOR MAKES NO GUARANTEES AS TO BUILDING METHODS, MATERIALS, OR CONSTRUCTION.

herowith as # 0700 84661

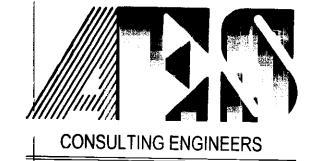

WILLIAMSBURG • RICHMOND • GLOUCESTER


5248 Olde Towne Road, Suite 1 Williamsburg, Virginia 23188 (757) 253-0040 Fax (757) 220-8994 "EXHIBIT 1"

PLAN OF CONDOMINIUM

WILLIAMSBURG VILLAGE AT NORGE CONDOMINIUM
PHASE 11-A
UNITS #1101, 1102, 1103, AND 1104

STONEHOUSE DISTRICT

COUNTY OF JAMES CITY

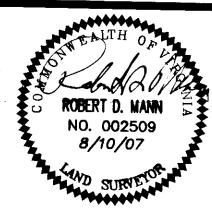

No. DATE	REVISION / COMMENT / NOTE	BY
	Retsy Woodridge Clerk	
	BETSY B. WOOLRIDGE, CLERK	
	DOCUMENT #	
	at 3.45 AM/PM PR - PC	
	Circuit Court: This PLAT was recorded on 30 Museu 2007	
	City of Williamsburg & County of James City	

Designed VMB/JAG	Drawn AWT/MLH
Scale	Date
1/8"=1"	8/10/07
Project No.	
9286-2	
Drawing No.	
9 of 9	