
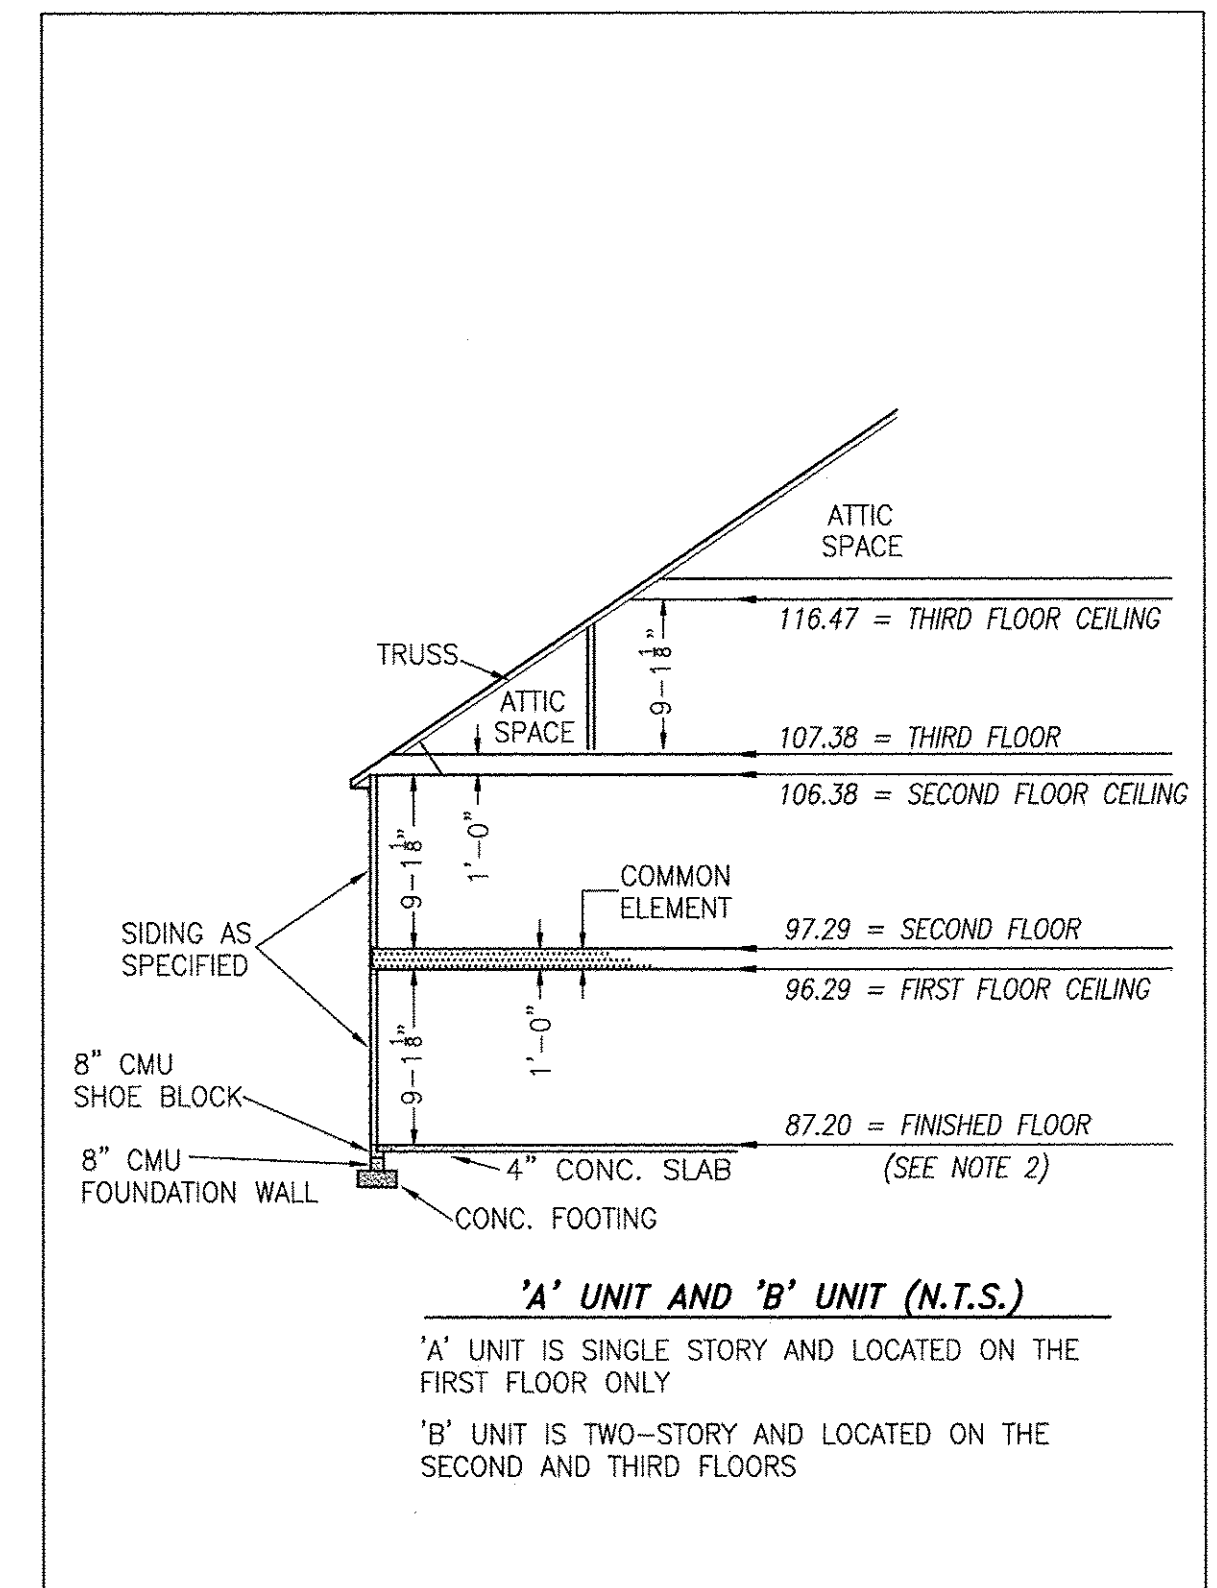


180016847

BUILDING 12 (DUPLEX)

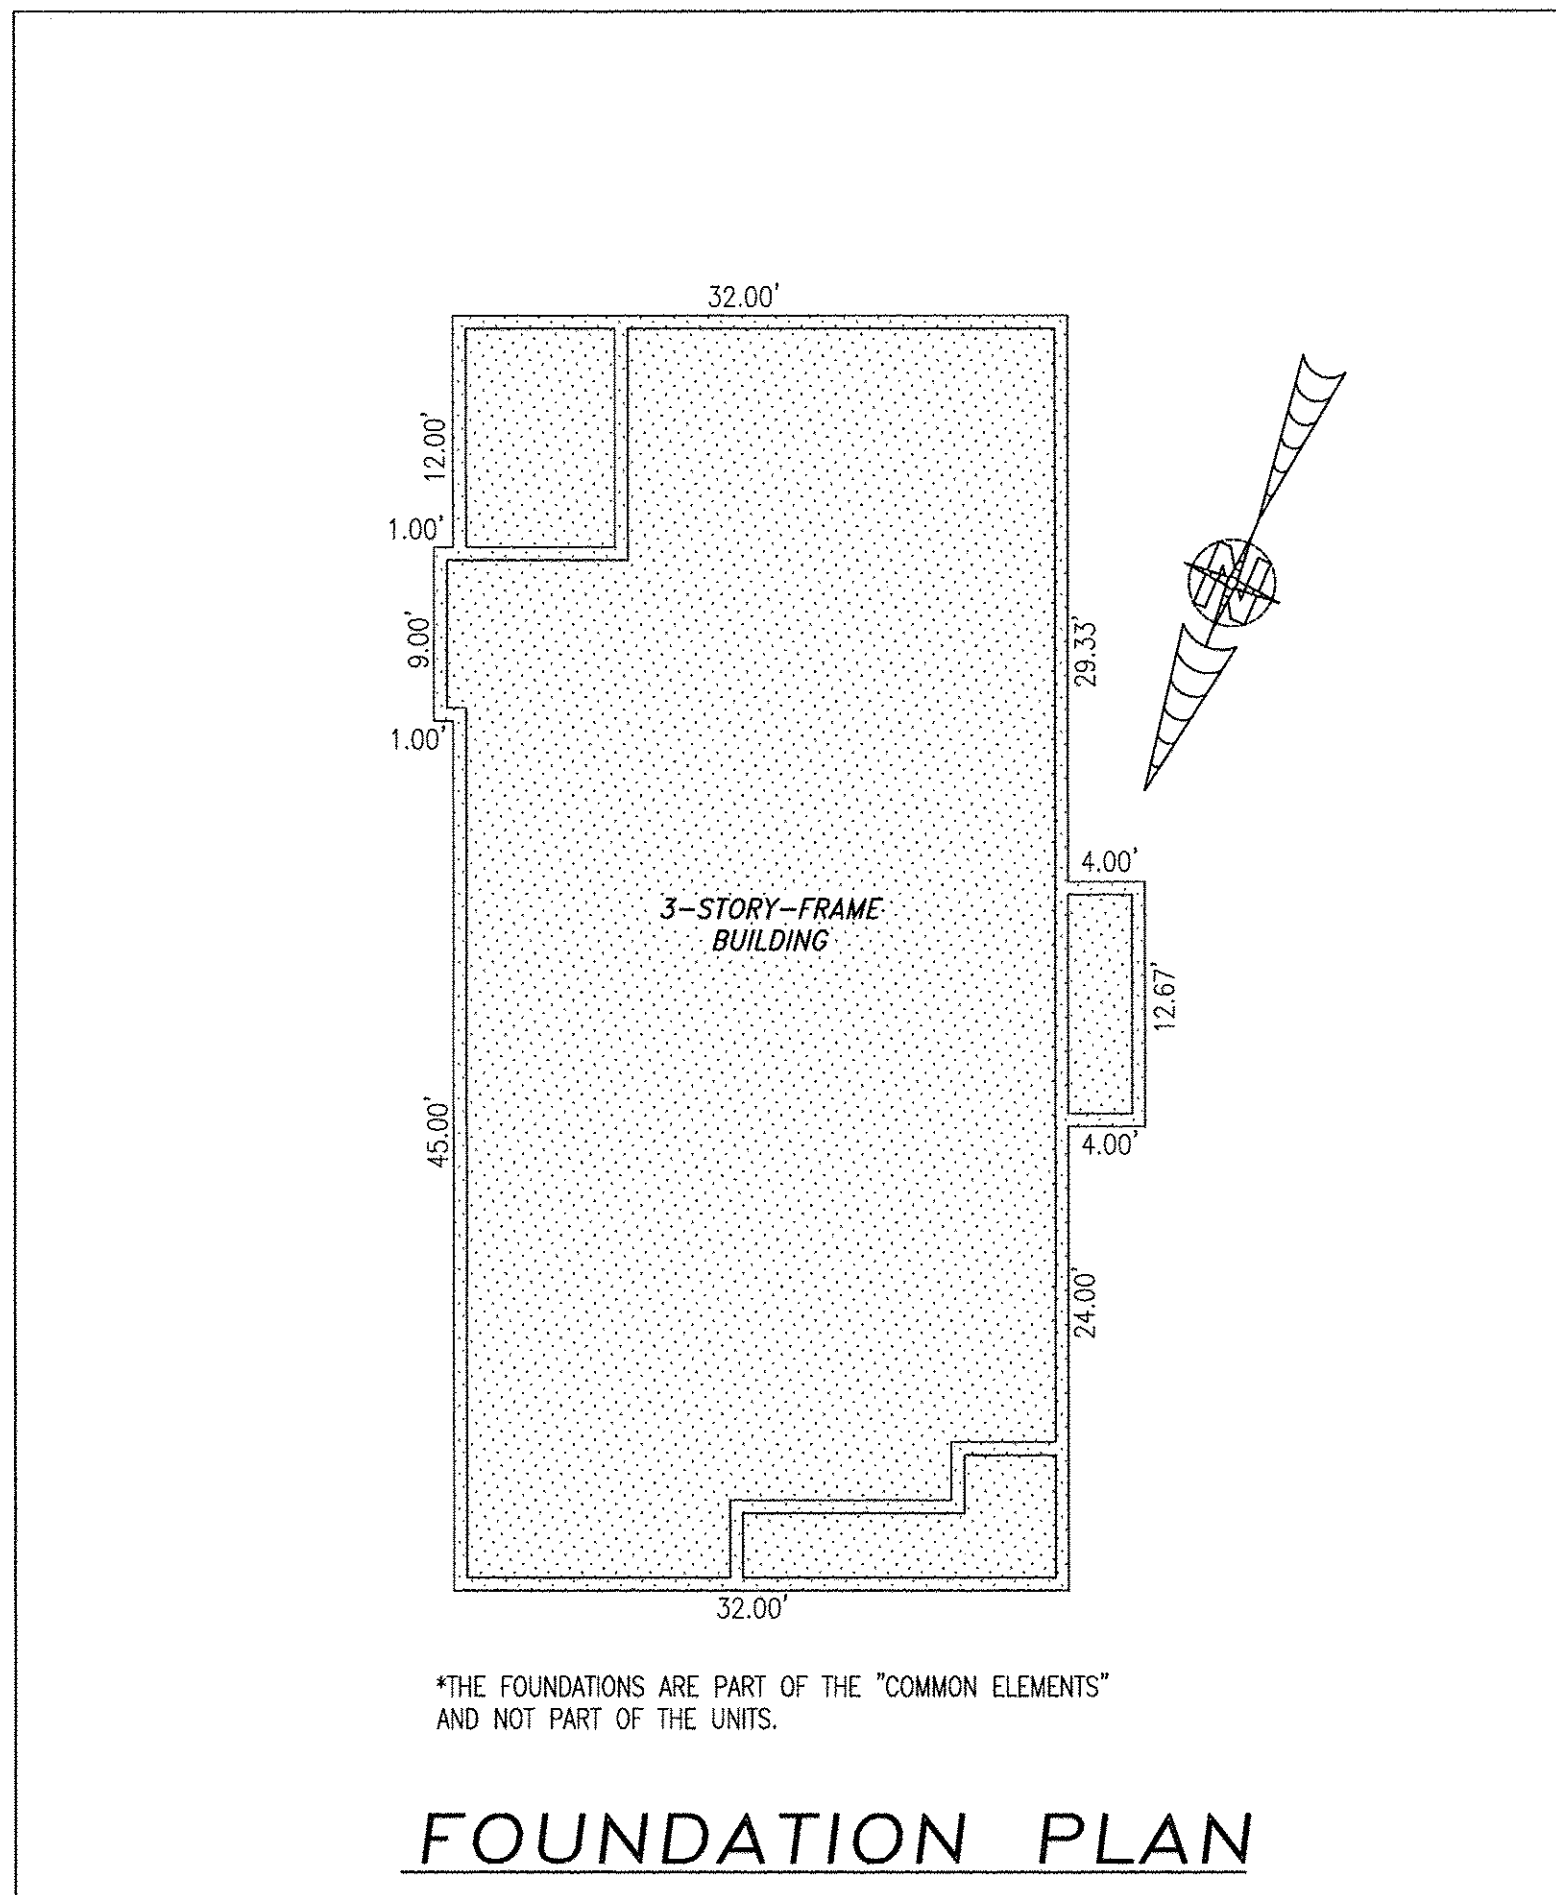

TYPICAL BUILDING SECTION

NOT TO SCALE (N.T.S.)


NOTES:

1. VERTICAL DATUM REFERENCE: NATIONAL GEODETIC VERTICAL DATUM OF 1929 (NGVD29).
2. FINISHED FLOOR ELEVATION SHOWN WAS TAKEN FROM AS-BUILT SURVEY OF BUILDING #12 (DUPLEX) THE PROMENADE AT JOHN TYLER BY HAYDEN FRYE AND ASSOCIATES. FIELD WORK WAS PERFORMED ON 05-23-18.

I HEREBY CERTIFY THAT THIS PLAN IS ACCURATE AND THAT IT COMPLIES WITH THE PROVISIONS OF THE CODE OF VIRGINIA OF 1950 AS AMENDED, § 55-79.58 AND I FURTHER CERTIFY THAT ALL UNITS THEREOF DEPICTED HEREON, PURSUANT TO THE CODE OF VIRGINIA § 55-79.58B, ARE SUBSTANTIALLY COMPLETE.

5 Large/Small Plat(s) Recorded
 herewith as # 180016847

City of Williamsburg & County of James City
 Circuit Court: This PLAT was recorded on
 Oct 19 2018
 at 2:31 AM/PM, PB PG
 Document # 180016847
 MONA A. FOLEY, CLERK
Mona Foley, Clerk

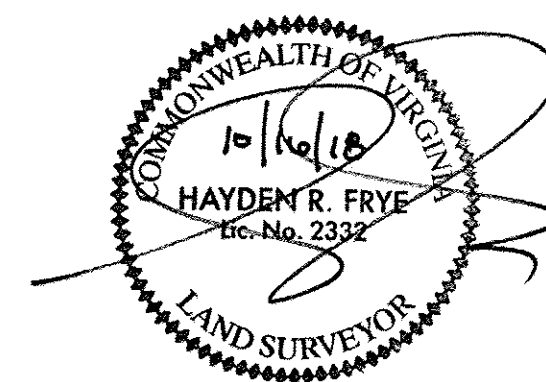


THIS SHEET: FOUNDATION PLAN AND SECTION

PHASE 12
CONDOMINIUM PLAT AND PLAN
 OF
THE PROMENADE
 AT
JOHN TYLER
 A CONDOMINIUM
 JAMES CITY COUNTY, VIRGINIA

Job# 160921

Hayden Frye and Associates, Inc.

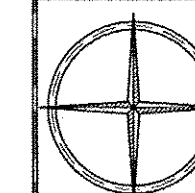

Land Surveyors


333 KELLAM ROAD, SUITE 200
 VIRGINIA BEACH, VA., 23462
 PH: (757) 491-7228 FX: (757) 491-7229

DATE: OCTOBER 15, 2018

SCALE: 1"=10'

SHEET 4 OF 5 THIS PHASE

JCC Subdivision Agent Approval Not Required *E64*

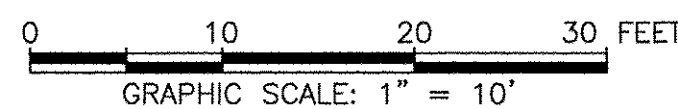

-INDICATES COMMON ELEMENT