


ROBERT BRANSCOMBE

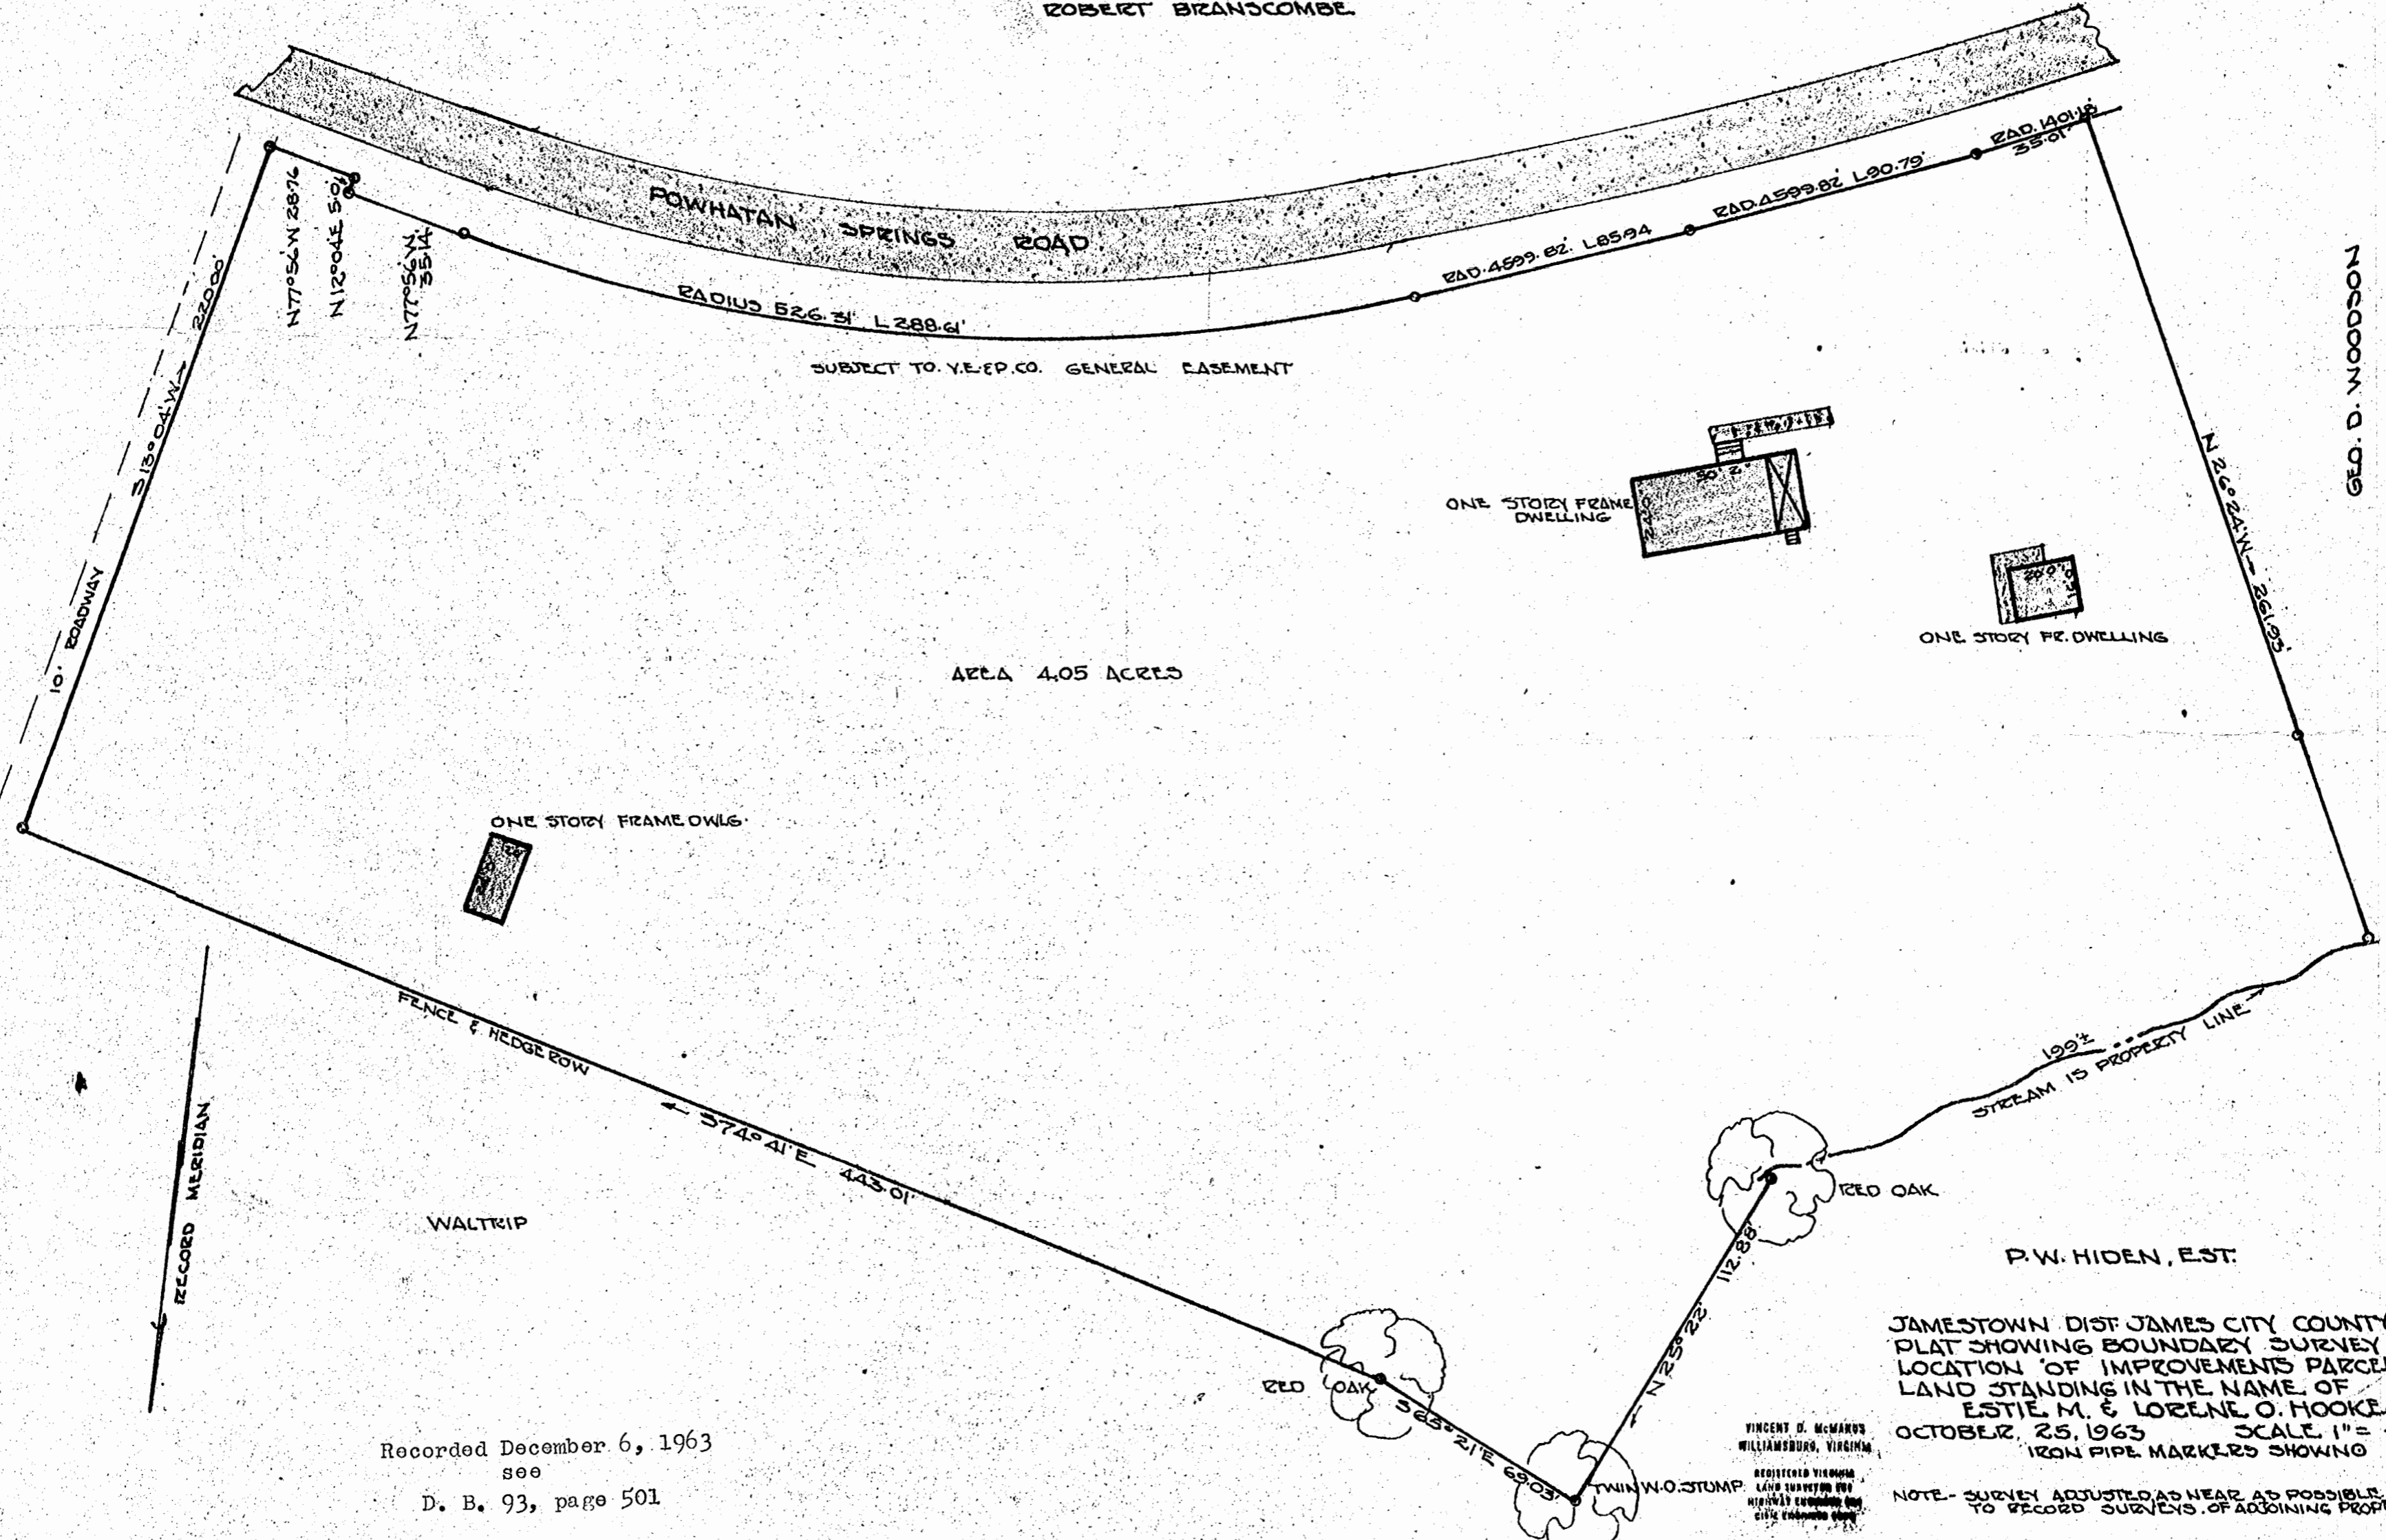

Recorded December 6, 1963
 see
 D. B. 93, page 501

JAMESTOWN DIST JAMES CITY COUNTY VA.
 PLAT SHOWING BOUNDARY SURVEY AND
 LOCATION OF IMPROVEMENTS PARCEL OF
 LAND STANDING IN THE NAME OF
 ESTIE M. & LORENE O. HOOKER.
 OCTOBER, 25, 1963 SCALE 1" = 40'
 IRON PIPE MARKERS SHOWING

VINCENT D. McMANUS
 WILLIAMSBURG, VIRGINIA
 REGISTERED VIRGINIA
 LAND SURVEYOR NO. 100
 HIGHWAY 100
 CITY OF WILLIAMSBURG

NOTE - SURVEY ADJUSTED AS NEAR AS POSSIBLE
 TO RECORD SURVEYS OF ADJOINING PROPERTY