


Scale: 1"=100'

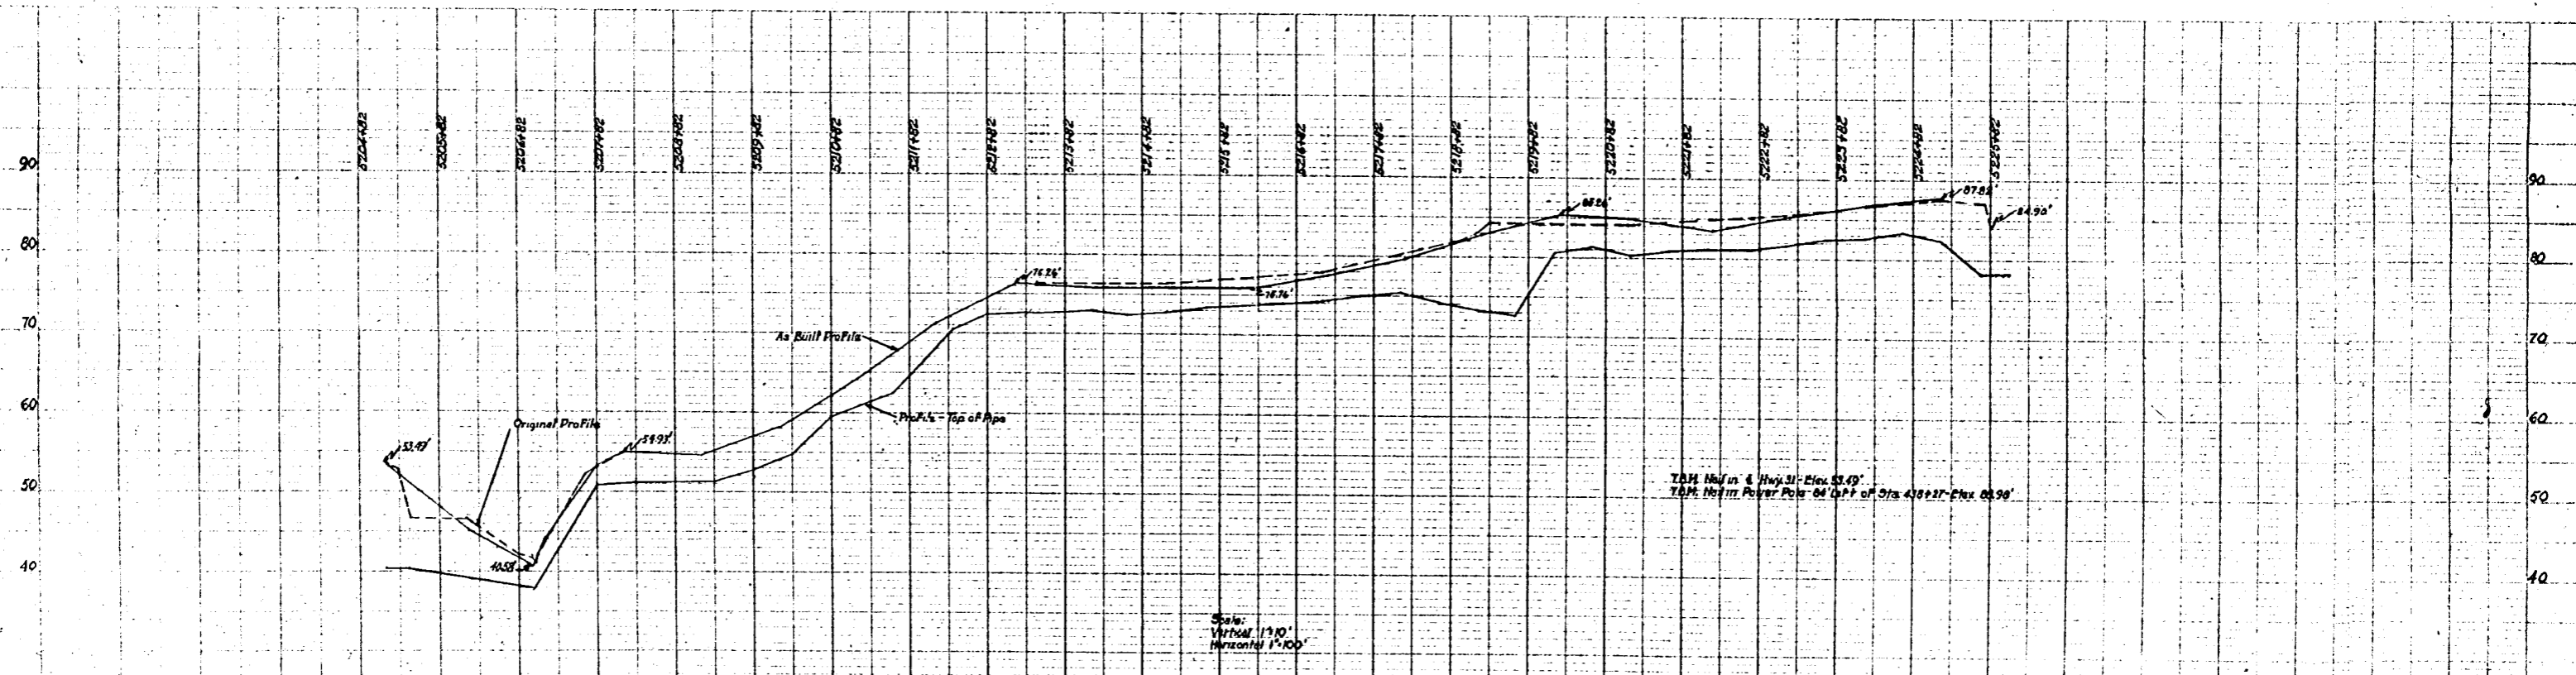

Scale:
Vertical 1"=10'
Horizontal 1"=100'

See D. B. 98 page 232
Nov 13, 1964
Virginia Blanchard, Clerk

COLONIAL PIPELINE COMPANY ATLANTA, GEORGIA		DRWEN 442
AS BUILT 14" PRODUCTS PIPELINE ACROSS PROPERTY OF DOGWOOD LAND CORPORATION		NOTES No. 42
JAMES CITY COUNTY, VIRGINIA		SCALE 1"=100'
		DATE 4-6-64
		CHECKED
		C-150-PL-1056