

TOTAL AREA: 117,935 s.f.
2.69 ac.

JAMES CITY COUNTY ZONING
BUILDING SETBACK REQUIREMENTS:
FRONT (RTS 60) - 50'
SIDE & REAR - 20'

RECORD RECORDED IN
P.L. NO. 39 PAGE 36


PROPERTY IS NOT
IN FLOOD ZONE A
PROPERTY SEV 120.0 ± BASED ON M.S.L.
PROPERTY DOES NOT ADJOIN TIDAL WATERS

John W. Ward

APPROVED
Surveyed by *John W. Ward*
J. W. W. 242
John W. Ward

SPICED - M&K CO. 1984
CEN 12-5-83

AS BUILT SURVEY OF
LIGHTFOOT MOTOR LODGE, PROPERTY OF
L. A. & G. CORPORATION
JAMES CITY COUNTY, VA.
1984 FEB 14, 1985
EQUIS SURVEYING CO., P.O. WILLIAMSBURG, VA

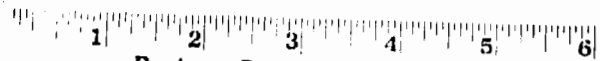

Business Records Corporation
1032 East Lindsey Street • Greensboro, N.C. 27405