

THE PLATTING OF THE LAND HEREON SHOWN IS WITH THE FREE CONSENT AND IN ACCORDANCE WITH THE DESIRE OF THE UNDERSIGNED TRUSTEES. CRESTAR BANK (INST#970008879, PG. 57, 4/30/93) CONSENTED TO:

H. Mac Weaver, II
H. MAC WEAVER, II, TRUSTEE

Joseph W. Kesterson
JOSEPH W. KESTERSON, TRUSTEE

(EITHER OF WHOM MAY ACT)

I, Madonna W. Monella NOTARY PUBLIC IN AND FOR THE City OF Virginia Beach, VIRGINIA, DO HEREBY CERTIFY THAT THE ABOVE NAMED PERSON WHOSE NAME IS SIGNED TO THE FOREGOING WRITING HAS ACKNOWLEDGED THE SAME BEFORE ME IN MY City AND STATE AFORESAID. GIVEN UNDER MY HAND THIS 19th DAY OF March, 1999. mm 2001


Madonna W. Monella
NOTARY PUBLIC

MY COMMISSION EXPIRES 12-31-2003

PLAT OF SUBDIVISION
WATERFORD
AT
POWHATAN SECONDARY
PHASE EIGHTEEN
BERKELEY DISTRICT
JAMES CITY COUNTY, VIRGINIA

DATE: 10/21/98	SHEET 1 OF 3	SCALE: N/A
PROJECT NO: 97-008	DRAWN BY: SJB	

SA SLEDD & ASSOCIATES, P.C.
ENGINEERS PLANNERS SURVEYORS
11832 ROCK LANDING DRIVE, SUITE 203
NEWPORT NEWS, VIRGINIA 23606
(757) 873-3386

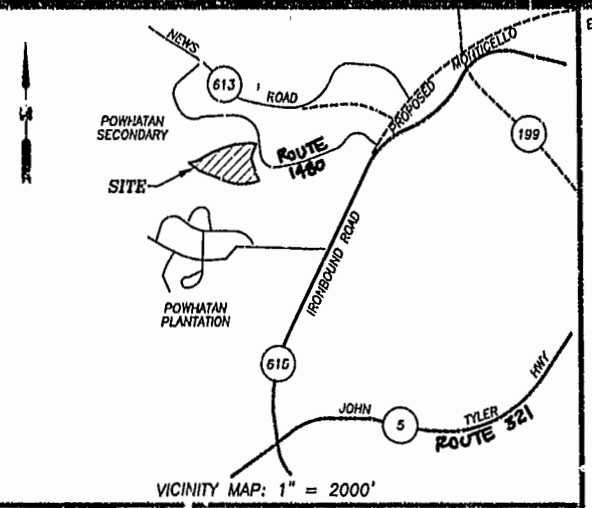

OWNER'S CERTIFICATE

THE SUBDIVISION OF LAND SHOWN ON THIS PLAT IS WITH THE FREE CONSENT AND IN ACCORDANCE WITH THE DESIRE OF THE UNDERSIGNED OWNERS, PROPRIETORS AND OR TRUSTEES.

TERRY/PETERSON RESIDENTIAL TWO, L.L.C.
A VIRGINIA LIMITED LIABILITY COMPANY

BY: John H. Peterson, Jr. 3.14.01
DATE

**CERTIFICATE OF NOTARIZATION
COMMONWEALTH OF VIRGINIA**

CITY/COUNTY OF Virginia Beach, I, Donna Y. Watts A NOTARY PUBLIC IN AND FOR THE CITY/COUNTY AND STATE AFORESAID, DO HEREBY CERTIFY THAT THE PERSONS WHOSE NAMES ARE SIGNED TO THE FOREGOING WRITING HAVE ACKNOWLEDGED THE SAME BEFORE ME IN THE CITY/COUNTY AFORESAID GIVEN UNDER MY NAME THIS 14th DAY OF March, 2001, 1999. MY COMMISSION EXPIRES 4/30/01

Donna Y. Watts
NOTARY PUBLIC

CERTIFICATE OF SOURCE OF TITLE

THE PROPERTY SHOWN ON THIS PLAT WAS CONVEYED BY POWHATAN ENTERPRISES, INC., A VIRGINIA CORPORATION, TO TERRY/PETERSON RESIDENTIAL TWO, L.L.C., A VIRGINIA LIMITED LIABILITY COMPANY, BY DEED DATED MAY 1, 1997 AND RECORDED IN THE OFFICE OF THE CLERK OF THE CIRCUIT COURT OF THE COUNTY OF JAMES CITY IN INSTRUMENT NUMBER 97008878, PAGE 5.

**STATE OF VIRGINIA
COUNTY OF JAMES CITY**

IN THE CLERK'S OFFICE OF THE CIRCUIT COURT OF THE COUNTY OF JAMES CITY, THIS 18th DAY OF July, 2001, 1999. THE MAP SHOWN HEREON WAS PRESENTED AND ADMITTED TO THE RECORD AS THE LAW DIRECTS.

Betsy B. Woolridge, CLERK
TESTE: By: Dawn R. Martin, Dep. Clerk
CLERK

PLAT BOOK 82, PAGE 70-72

GENERAL NOTES:

1. PROPERTY IS ZONED RESIDENTIAL PLANNED COMMUNITY DISTRICT, R-4.
2. TAX MAP NUMBER OF PROPERTY: ~~(38-4)(2-4)~~ & ~~(38-4)(12-4)~~ (37-4)(2-7)
3. ALL STREETS DESIGNATED AS PRIVATE ARE TO BE HELD AS COMMON AREAS BY THE HOME OWNERS ASSOCIATION.
4. THIS PROPERTY IS SERVED BY PUBLIC WATER & SEWER.
5. ALL UTILITIES SHALL BE PLACED UNDERGROUND IN ACCORDANCE WITH SECTION ~~17~~¹⁹-33 OF THE SUBDIVISION ORDINANCE.
6. ALL DRAINAGE EASEMENTS WILL BE PRIVATE.
7. WETLANDS AND LAND WITHIN THE RESOURCE PROTECTION AREAS SHALL REMAIN IN A NATURAL UNDISTURBED STATE EXCEPT FOR THOSE ACTIVITIES PERMITTED BY SECTION 23-9C(1) OF THE JAMES CITY COUNTY CODE.
8. MONUMENTS WILL BE SET IN ACCORDANCE WITH SECTION ~~17~~¹⁹-34 THROUGH ~~17~~¹⁹-36 OF THE JAMES CITY COUNTY SUBDIVISION ORDINANCE.
9. STREETS IN THIS SUBDIVISION ARE PRIVATE STREETS WHICH DO NOT MEET STATE DESIGN STANDARDS AND WILL NOT BE MAINTAINED BY THE VIRGINIA DEPARTMENT OF TRANSPORTATION OR JAMES CITY COUNTY.

Williamsburg/James City County
9:35 AM
Recorded 18 day of July 2001
DOCUMENT # 21002461
By: Dawn R. Martin, Dep. Clerk
BETSY B. WOOLRIDGE, CLERK

SURVEYOR'S CERTIFICATE

I HEREBY CERTIFY THAT TO THE BEST OF MY KNOWLEDGE OR BELIEF, THIS PLAT COMPLIES WITH THE REQUIREMENTS OF THE BOARD OF SUPERVISORS AND ORDINANCES OF THE COUNTY OF JAMES CITY, VIRGINIA.

W. Page Cockrell 8-23-99
DATE



AREA TABLE

TOTAL AREA OF THIS PHASE .244 AC.

CERTIFICATE OF APPROVAL

THIS SUBDIVISION IS APPROVED BY THE UNDERSIGNED IN ACCORDANCE WITH EXISTING SUBDIVISION REGULATIONS AND MAY BE ADMITTED TO RECORD.

W. Page Cockrell
DATE
SUBDIVISION AGENT OF
JAMES CITY COUNTY