



(757) 253-0040 Fax (757) 220-8994 PHASE X

OWNER/DEVELOPER: MARRIOTT CWNERSHIP RESORTS, INC. POWHATAN DISTRICT JAMES CITY COUNTY VIRGINIA

NO. 002723 AND SURVEYOR


		City of Williamsburg & County of James City Circuit Court: This PLAT was recorded on	 _
$\neg$		at 10:48 AMPH PB.85 PG.4-13	 _
二		DOCUMENT #	
		Belig Wholi loge , sup. clock	 -
No.	DATE	REVISION / COMMENT / NOTE	 Đ,

Designed	Drawn		
ADS	JFS		
Scale	Date		
1"=100"	4/11/01		
Project No.			
773	773911		
Drawing No.			
1 OF 10			

BOLD DIMENSIONS ARE BASED UPON ACTUAL FIELD MEASUREMENTS TAKEN AT OUTSIDE FACE OF BRICK. OTHER BUILDING DIMENSIONS AND DETAILS SHOWN ARE PER PLANS BY CMSS ARCHITECTS, P.C..

(CE) COMMON ELEMENT

(LCE) LIMITED COMMON ELEMENT

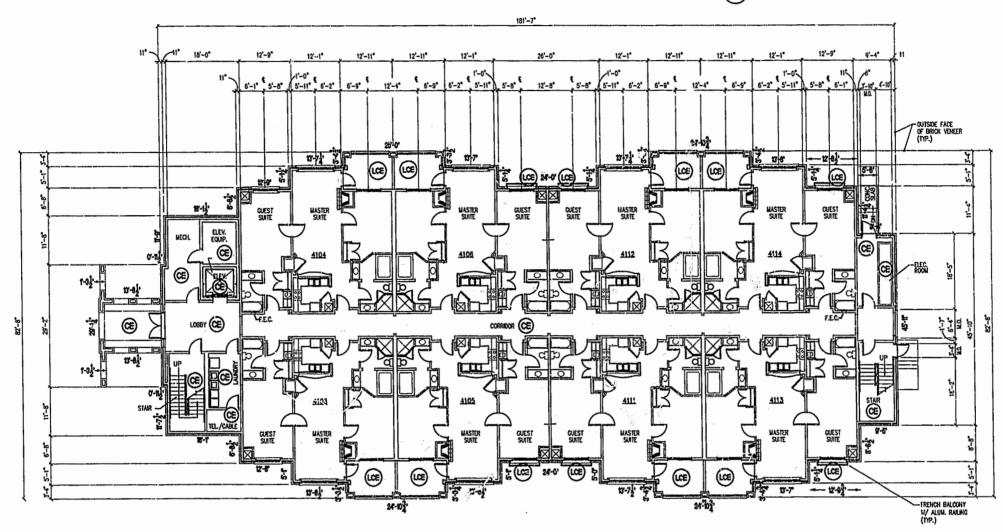

# FIRST FLOOR PLAN

(NOT TO SCALE)

- THE LOWER (HORIZONTAL) BOUNDARY OF EACH UNIT IN BUILDING 40CO SHOWN ON THE PLAT AS LOCATED ON PHASE X IS THE HORIZONTAL PLANE OF THE UPPER SURFACE OF THE FLOOR SLAB OR CONCRETE FLOOR TOPPING OF THE UNIT.
- THE UPPER (HORIZONTAL) BOUNDARY OF EACH OF THE UNITS IN BUILDING 4000 SHOWN ON THE PLAT AS LOCATED ON PHASE X IS THE HORIZONTAL PLANE(S) OF THE LOWER SURFACE OF THE FLOOR JOISTS (OR, IN THE CASE OF THIRD FLOOR UNITS, THE LOWER SURFACE OF THE BOTTOM CHORD OF THE ROOF TRUSSES) CONSTITUTING A PART OF THE CEILING OF THE UNIT.
  - SEE TWELFTH AMENDMENT TO DECLARATION OF CONDOMINIUM OF MANOR CLUB AT FORD'S COLONY, A CONDOMINIUM (PHASE X CONDOMINIUM AGREEMENT) FOR A MORE DETA'LEO DESCRIPTION.



# CERTIFICATION FOR PLANS

"THE UNDERSIGNED, A LICENSED LAND SURVEYOR, DOES HEREBY CERTIFY THAT THESE PLANS ARE IN COMPLIANCE WITH VA. CODE ANN, SUBSECTIONS 55-79.58 B AND F. IT BEING UNDERSTOOD THAT SUCH UNITS ARE BEING SUBJECTED TO A TIME-SHARE INSTRUMENT PURSUANT TO VA. CODE ANN, SECTION 55-367 AND THUS VA. CODE ANN. SUBSECTION 55-79.58 D APPLIES. 1 FURTHER CERTIFY THAT ALL UNITS OR PORTIONS THEREOF DEPICTED HEREON HAVE BEEN SUBSTANTIALLY COMPLETED."

A. D. SEBERT, L.S.



5248 Olde Towne Road, Suite 1 Williamsburg, Virginia 23188 (757) 253-0040 Fax (757) 220-8994

PLAT OF CONDOMINIUM MANOR CLUB AT FORD'S COLONY PHASE X

EXHIBIT A-3

OWNER/DEVELOPER: MARRIOTT OWNERSHIP RESORTS, INC. VIRGINIA POWHATAN DISTRICT JAMES CITY COUNTY


	City of Williamsburg & County of James City Circuit Court: This PLAT was recorded on	
	BI 10:48 AMMM. PB 85. PG 4-13. — DOCUMENT # 0 2 0 0 0 2823.	
	BETSY B, WOOLRIDGE, CLERK  AND LOOKING BD. Clerk	_
No. DATE	REVISION / COMMENT / NOTE	

Н	Designed	Drown
Н	ADS	JFS
П	Scale	Date
	NOTED	4/11/01
ı	Projec	et No.
Н	773	9-11
П	Drawle	ng No.
	20	F10

NOTE:

BOLD DIMENSIONS ARE BASED UPON ACTUAL FIELD MEASUREMENTS TAKEN AT OUTSIDE FACE OF BRICK. OTHER BUILDING DIMENSIONS AND DETAILS SHOWN ARE PER PLANS BY CMSS ARCHITECTS, P.C.. E) COMMON ELEMENT

CE) LIMITED COMMON ELEMENT

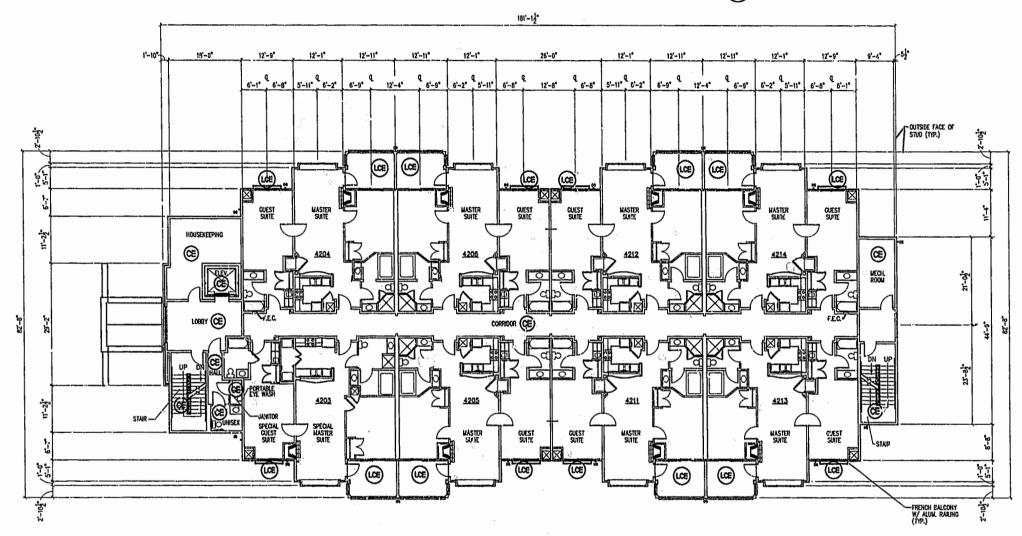

# SECOND FLOOR PLAN

(NOT TO SCALE)

#### MOTES: 4

- 1. THE LOWER (HORIZONTAL) BOUNDARY OF EACH UNIT IN BUILDING 4000 SHOWN ON THE PLAT AS LOCATED ON PHASE X IS THE HORIZONTAL PLANE OF THE UPPER SURFACE OF THE FLOOR SLAB OR CONCRETE FLOOR TOPPING OF THE UNIT.
- 2. THE UPPER (HORIZONTAL) BOUNDARY OF EACH OF THE UNITS IN BUILDING 4000 SHOWN ON THE PLAT AS LOCATED ON PHASE X IS THE HORIZONTAL PLANE(S) OF THE LOWER SURFACE OF THE FLOOR JOISTS (OR, IN THE CASE OF THIRD FLOOR UNITS, THE LOWER SURFACE OF THE BOTTOM CHORD OF THE ROOF TRUSSES) CONSTITUTING A PART OF THE CEILING OF THE UNIT.
  - SEE TWELFTH AMENDMENT TO DECLARATION OF CONDOMINIUM OF MANOR CLUB AT FORD'S COLONY, A CONDOMINIUM (PHASE X CONDOMINIUM AGREEMENT) FOR A MORE DETAILED DESCRIPTION.



#### CERTIFICATION FOR PLANS

"THE UNDERSIGNED, A LICENSED LAND SURVEYOR, DOES HEREBY CERTIFY THAT THESE PLANS ARE IN COMPLIANCE WITH VA. CODE ANN. SUBSECTIONS 55-79.58 B AND F. IT BEING UNDERSTOOD THAT SUCH UNITS ARE BEING SUBJECTED TO A TIME-SHARE INSTRUMENT PURSUANT TO VA. CODE ANN. SECTION 55-367 AND THUS VA. CODE ANN. SUBSECTION 55-79.58 D APPLIES. I FURTHER CERTIFY THAT ALL UNITS OR PORTIONS THEREOF DEPICTED HEREON HAVE BEEN SUBSTANTIALLY COMPLETED."

A. D. SEBERT, L.S.

4/11/01

EXHIBIT A-3

PLAT OF CONDOMINIUM MANOR CLUB AT FORD'S COLONY PHASE X

OWNER/DEVELOPER: MARRIOTT OWNERSHIP RESORTS, INC.
POWHATAN DISTRICT JAMES CITY COUNTY VIRGINIA

		City of Williamsburg & County of James City Circuit Court: This PLAT was recorded on 30 Jan 2022 at 10:48 AMRAM, PB 85 PG 4-13 DOCUMENT # 0.200.2823 BETSY, B. WOOLRIDGE, CLEHK CASTALL DOMESTICAL, 1949, Clork	
No.	DATE	REVISION / COMMENT / NOTE	١


	Designed	Drown			
	ADS	JFS			
	Scole	Date			
	NOTED	4/11/01			
1	Project No.				
Į	7739-11				
Ì	Drawing No.				
	3 OF 10				

CONSULTING ENGINEERS

5248 Olde Towne Road, Suite 1 Williamsburg, Virginia 23188 (757) 253-0040 Fax (757) 220-8994 BOLD DIMENSIONS ARE BASED UPON ACTUAL FIELD MEASUREMENTS TAKEN AT OUTSIDE FACE OF BRICK. OTHER BUILDING DIMENSIONS AND DETAILS SHOWN ARE PER PLANS BY CMSS ARCHITECTS, P.C..

COMMON ELEMENT

LIMITED COMMON ELEMENT

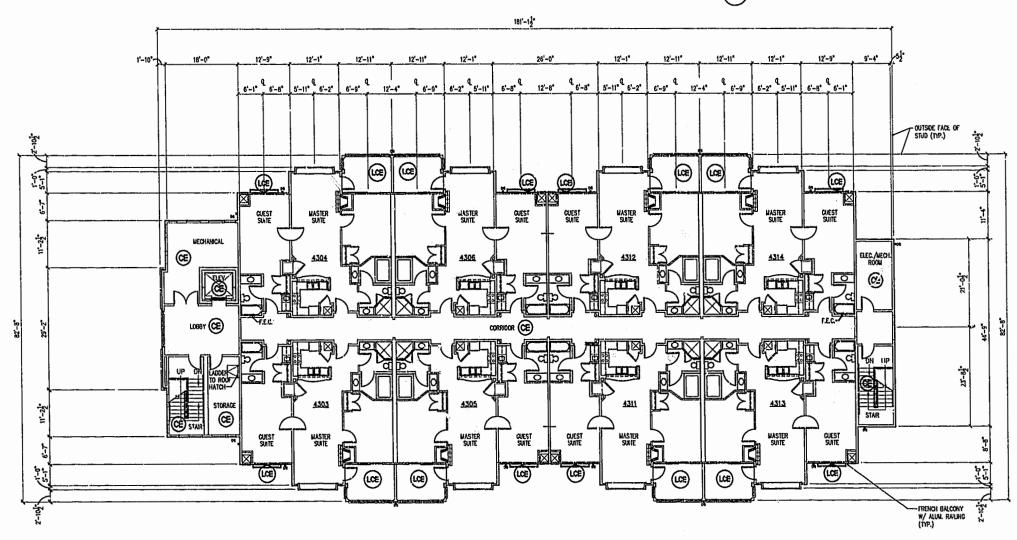

# THIRD FLOOR PLAN (NOT TO SCALE)

- THE LOWER (HORIZONTAL) BOUNDARY OF EACH UNIT IN BUILDING 4000 SHOWN ON THE PLAT AS LOCATED ON PHASE X IS THE HORIZONTAL PLANE OF THE UPPER SURFACE OF THE FLOOR SLAB OR CONCRETE FLOOR TOPPING OF THE UNIT.
- 2. THE UPPER (HORIZONTAL) BOUNDARY OF EACH OF THE UNITS IN BUILDING 4000 SHOWN ON THE PLAT AS LOCATED ON PHASE X IS THE HORIZONTAL PLANE(S) OF THE LOWER SURFACE OF THE FLOOR JOISTS (OR, IN THE CASE OF THIRD FLOOR UNITS, THE LOWER SURFACE OF THE BOTTOM CHORD OF THE ROOF TRUSSES) CONSTITUTING A PART OF THE CEILING OF THE UNIT.
  - SEE TWELFTH AMENDMENT TO DECLARATION OF CONDOMINIUM OF MANOR CLUB AT FORD'S COLONY, A CONDOMINIUM (PHASE X CONDOMINIUM AGREEMENT)
    FOR A MORE DETAILED DESCRIPTION.



### CERTIFICATION FOR PLANS


"THE UNDERSIGNED, A LICENSED LAND SURVEYOR, DOES HEREBY CERTIFY THAT THESE PLANS ARE IN COMPLIANCE WITH VA. CODE ANN. SUBSECTIONS 55-79.58 B AND F. IT BEING UNDERSTOOD THAT SUCH UNITS ARE BEING SUBJECTED TO A TIME-SHARE INSTRUMENT PURSUANT TO VA. CODE ANN. SECTION 55-367 AND THUS VA. CODE ANN. SUBSECTION 55-79.58 D APPLIES. I FURTHER CERTIFY THAT ALL UNITS OR PORTIONS THEREOF DEPICTED HEREON HAVE BEEN SUBSTANTIALLY COMPLETED."

A. D. SEBERT, L.S.

EXHIBIT A-3

PLAT OF CONDOMINIUM MANOR CLUB AT FORD'S COLONY PHASE X


JAMES CITY COUNTY VIRGINIA

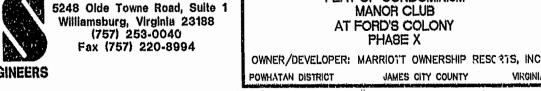

	 City of Williamsburg & County of James City	
_	 Circuit Court: This PLAT was recorded on	
	 al 10:48 AMPM. PB 85 PG 4-13	
	 DOCUMENT # 0 2040 2823	
-	 BETSY, B. WOOLRIDGE, CLERK	
	 - Olly Worlinge, Dop. Clock -	

ADS **JFS** NOTED 4/11/01 7739-11 Drawing No. 4 OF 10

**CONSULTING ENGINEERS** 

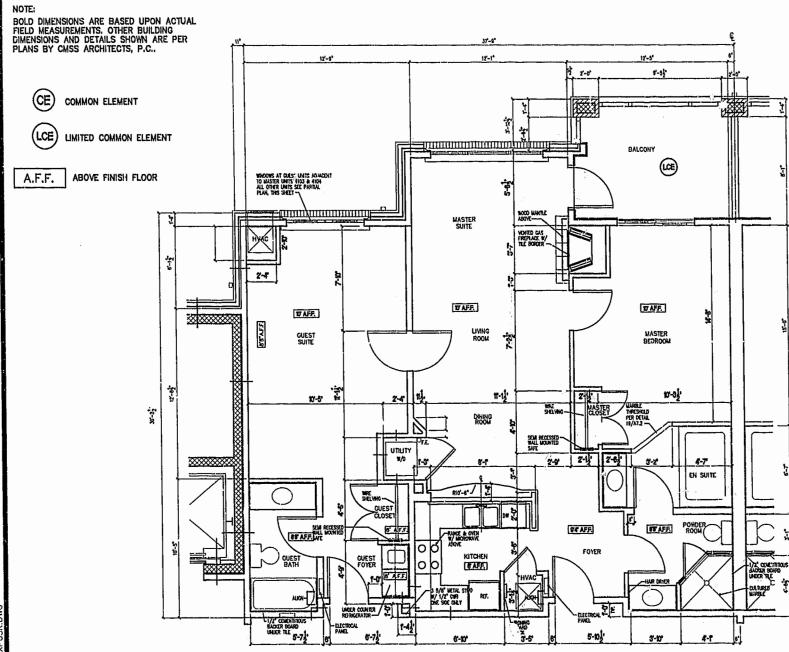


TYPICAL FIRST FLOOR UNIT PLAN

(NOT TO SCALE)

## NOTES: \*

- 1. THE LOWER (HORIZONTAL) BOUNDARY OF EACH UNIT IN BUILDING 4000 SHOWN ON THE PLAT AS LOCATED ON PHASE X IS THE HORIZONTAL PLANE OF THE UPPER SURFACE OF THE FLOOR SLAE OR CONCRETE FLOOR TOPPING OF THE UNIT.
- 2. THE UPPER (HORIZONTAL) BOUNDARY OF EACH OF THE UNITS IN BUILDING 4000 SHOWN ON THE PLAT AS LOCATED ON PHASE X IS THE HORIZONTAL PLANE(S) OF THE LOWER SURFACE OF THE FLOOR JOISTS (OR, IN THE CASE OF THIRD FLCOR UNITS, THE LOWER SURFACE OF THE BOTTOM CHORD OF THE ROOF TRUSSES) CONSTITUTING A PART OF THE CEILING OF THE UNIT.
  - SEE TWELFTH AMENDMENT TO DECLARATION OF CONDOMINIUM OF MANOR CLUB AT FORD'S COLONY, A CONDOMINIUM (PHASE X CONDOMINIUM AGREEMENT) FOR A MORE DETAILED DESCRIPTION.

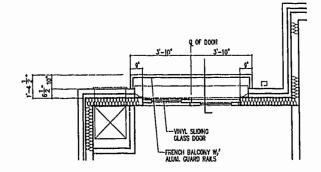

# PARTIAL FLOOR PLAN - GUEST PLAN

NOTE: TYP. AT ALL UNITS EXCEPT WINDOWS AT GUEST UNITS ADJACENT TO MASTER UNITS 4103 & 4104

## FIRST FLOOR UNIT PLAN

UNIT NO.	ORIENTATION		
4103	MIRRORED		
4104 (TYPICAL)	SAME		
4105	SAME		
4106	MIRRORED		
4111	MÍRRORED		
4112	SAME		
4113	SAME		
4114	MIRRORED		



# CERTIFICATION FOR PLANS

"THE UNDERSIGNED, A LICENSED LAND SURVEYOR, DOES HEREBY CERTIFY THAT THESE PLANS ARE IN COMPLIANCE WITH VA. CODE ANN. SUBSECTIONS 55-79.58 B AND F. IT BEING UNDERSTOOD THAT SUCH UNITS ARE REING SUBJECTED TO A TIME-SHARE INSTRUMENT PURSUANT TO VA. CODE ANN. SECTION 55-367 AND THUS VA. CODE ANN. SUBSECTION 55-79.58 D APPLIES. I FURTHER CERTIFY THAT ALL UNITS OR FORTIONS THEREOF DEPICTED HEREON HAVE BEEN SUBSTANTIALLY COMPLETED."

A. D. SEBERT, L.S.

4/11/01



5248 Olde Towne Road, Suite 1 Williamsburg, Virginia 23188 (757) 253-0040 Fax (757) 220-8994 PLAT OF CONDOMINIUM MANOR CLUB AT FORD'S COLONY PHASE X

EXHIBIT A-3

OWNER/DEVELOPER: MARRIOTT OWNERSHIP RESORTS, INC.
POWHATAN DISTRICT JAMES CITY COUNTY VIRGINIA

		City of Williamsburg & County of James City Citcuit Court: This PLAT was recorded on at 10:48 AMMES PB \$5 PG 4-13.  DOCUMENT # 02000823  BETSY B, WOOLRIDGE, CLERK  DOLLAND AND AND AND AND AND AND AND AND AND	
No.	DATE	REVISION / COMMENT / NOTE	╬

Designed ADS	Drawn JFS
Scale NOTED	Date 4/11/01
	ot No. 9– <sup>4</sup> 1
1	ng No. F 10




BOLD DIMENSIONS ARE BASED UPON ACTUAL FIELD MEASUREMENTS. OTHER BUILDING DIMENSIONS AND DETAILS SHOWN ARE PER PLANS BY CMSS ARCHITECTS, P.C..

(CE) COMMON ELEMENT

LCE) LIMITED COMMON ELEMENT

A.F.F. ABOVE FINISH FLOOR

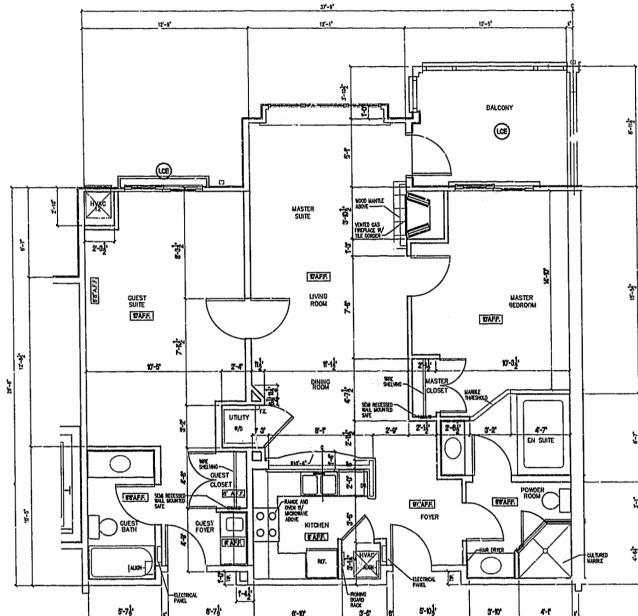

TYPICAL SECOND AND THIRD FLOOR UNIT PLAN (NOT TO SCALE)

## NOTES: 4

- 1. THE LOWER (HORIZONTAL) BOUNDARY OF EACH UNIT IN BUILDING 4000 SHOWN ON THE PLAT AS LOCATED ON PHASE X IS THE HORIZONTAL PLANE OF THE UPPER SURFACE OF THE FLOOR SLAB OR CONCRETE FLOOR TOPPING OF THE UNIT.
- 2. THE UPPER (HORIZONTAL) BOUNDARY OF EACH OF THE UNITS IN BUILDING 4000 SHOWN ON THE PLAT AS LOCATED ON PHASE X IS THE HORIZONTAL PLANE(S) OF THE LOWER SURFACE OF THE FLOOR JOISTS (OR, IN THE CASE OF THIRD FLOOR UNITS, THE LOWER SURFACE OF THE BOTTOM CHORD OF THE ROOF TRUSSES) CONSTITUTING A PART OF THE CEILING OF THE UNIT.
  - SEE TWELFTH AMENDMENT TO DECLARATION OF CONDOMINIUM OF MANOR CLUB AT FORD'S COLONY, A CONDOMINIUM (PHASE X CONDOMINIUM AGREEMENT) FOR A MORE DETAILED DESCRIPTION.

#### SECOND FLOOR UNIT PLAN

UNIT NO.	ORIENTATION	
4204 (TYPICAL)	SAME	
4205	SAME	
4206	MIRRORED	
4211	MIRRORED	
4212	SAME	
4213	SAME	
4214	MIRRORED	

### THIRD FLOOR UNIT PLAN

UNIT NO.

	-
4303 4304 (TYPICAL) 4305 4306	MIRRORED SAME SAME MIRRORED MIRRORED
4312	SAME
4313	SAME
4314	MIRRORED



ORIENTATION

# CERTIFICATION FOR PLANS

"THE UNDERSIGNED, A LICENSED LAND SURVEYOR, DOES HEREBY CERTIFY THAT THESE PLANS ARE IN COMPLIANCE WITH VA. CODE ANN. SUBSECTIONS 55-79.58 B AND F. IT BEING UNDERSTOOD THAT SUCH UNITS ARE BEING SUBJECTED TO A TIME-SHARE INSTRUMENT PURSUANT TO VA. CODE ANN. SECTION 55-367 AND THUS VA. CODE ANN. SUBSECTION 55-79.58 D APPLIES. I FURTHER CERTIFY THAT ALL UNITS OR PORTIONS THEREOF DEPICTED HEREON HAVE BEEN SUBSTANTIALLY COMPLETED."

A. D. SEBERT, L.S.

4/11/01



5248 Olde Towne Road, Suite 1 Williamsburg, Virginia 23188 (757) 253-0040 Fax (757) 220-8994 PLAT OF CONDOMINIUM MANOR CLUB AT FORD'S COLONY PHASE X

EXHIBIT A-3


OWNER/DEVELOPER: MARRIOTT OWNERSHIP RESORTS, INC.
POWHATAN DISTRICT JAMES CITY COUNTY MRGINIA

<u> </u>	City of Williamsburg & County of James City	
	Circuit Court: This PLAT was recorded on	
l	30 you 2000	
	nt 10:48 MM/PM PB 85 PG 4-13	
	DOCUMENT #	
	BETSY B. WOOLFIDGE, CLERK	
	- Billy St. Bolic age Dep. Clock	

7 1	Designed	Drawn	
11	AUS	JFS	
1	Scale	Date	
1	NOTED	4/11/01	
1	Project No.		
1	7739-11		
1	Drawing No.		
1	6 OF 10		

NOTE:

30LD DIMENSIONS ARE BASED UPON ACTUAL FIELD MEASUREMENTS. OTHER BUILDING DIMENSIONS AND DETAILS SHOWN ARE PER PLANS BY CMSS ARCHITECTS, P.C..

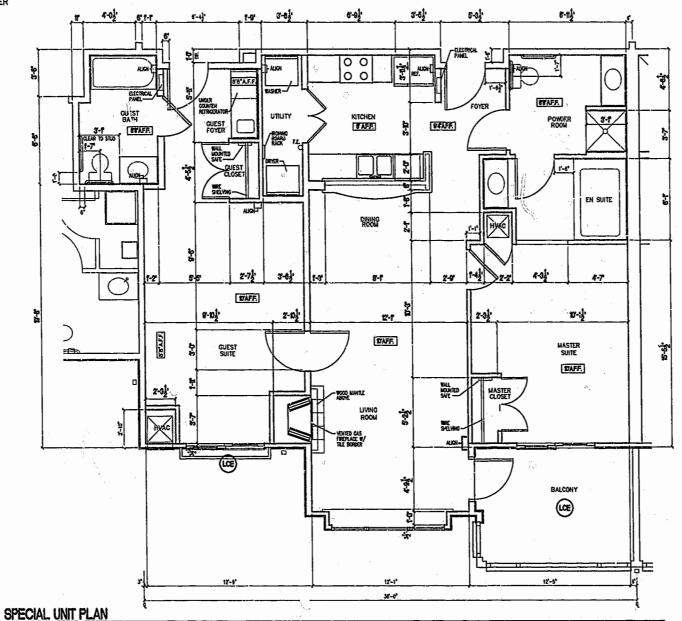

(CE) COMMON ELEMENT

LCE LIMITED COMMON ELEMENT

A.F.F. ABOVE FINISH FLOOR

SPECIAL UNIT FLOOR PLAN

UNIT NO. 4203



CERTIFICATION FOR PLANS

"THE UNDERSIGNED, A LICENSED LAND SURVEYOR, DOES HEREBY CERTIFY THAT THESE PLANS ARE IN COMPLIANCE WITH VA. CODE ANY, SUBSECTIONS 55-79.58 B AND F. IT BEING UNDERSTOOD THAT SUCH UNITS ARE BEING SUBJECTED TO A TIME-SHARE INSTRUMENT PURSUANT TO VA. CODE ANN. SECTION 55-367 AND THUS VA. CODE ANN. SUBSECTION 55-79.58 D APPLIES. I FURTHER CERTIFY THAT ALL UNITS OR PORTIONS THEREOF DEPICTED HEREON HAVE BEEN SUBSTANTIALLY COMPLETED."

A. D. SEBERT, LS.

4/11/01

NOTES: A

1. THE LOWER (HORIZONTAL) BOUNDARY OF EACH UNIT IN BUILDING 4000 SHOWN ON THE PLAT AS LOCATED ON PHASE X IS THE HORIZONTAL PLANE OF THE UPPER SURFACE OF THE FLOOR SLAB OR CONCRETE FLOOR TOPPING OF THE UNIT.

(NOT TO SCALE)

- 2. THE UPPER (HORIZONTAL) BOUNDARY OF EACH OF THE UNITS IN BUILDING 4000 SHOWN ON THE PLAT AS LOCATED ON PHASE X IS THE HORIZONTAL PLANE(S) OF THE LOWER SURFACE OF THE FLOOR JUISTS (OR, IN THE CASE OF THIRD FLOOR UNITS, THE LOWER SURFACE OF THE BOTTOM CHORD OF THE ROOF TRUSSES) CONSTITUTING A PART OF THE CEILING OF THE UNIT.
  - SEE TWELFTH AMENDMENT TO DECLARATION OF CONDOMINIUM OF MANOR CLUB AT FORD'S COLONY, A CONDOMINIUM (PHASE X CONDOMINIUM AGREEMENT) FOR A MORE DETAILED DESCRIPTION.




5248 Olde Towne Road, Suite 1 Williamsburg, Virginia 23188 (757) 253-0040 Fax (757) 220-8994 PLAT OF CONDOMINIUM MANOR CLUB AT FORD'S COLONY PHASE X

EXHIBIT A-3

OWNER/DEVELOPER: MARRIOTT OWNERSHIP RESORTS, INC.
POWHATAN DISTRICT JAMES CITY COUNTY VIRGINIA


City of Williamsburg & County of James Circuit Court: This PLAT was recorded at 10:48 AWEM PS 85 PG 9 DOCUMENT # 02.0028823	on	
at 10:48 AWRM P3 85 PG 4	13	
1 nonuseur # 020002823		_
I 7 princy a WOOLRIDGE, CLERK		
No. DATE REVISION / COMMENT / NOTE	ork	-

1	Designed	Drawn	
1	ADS	JFS	
1 1	Scale	Date	
1	NOTED	4/11/01	
ł	Project No. 7739–11		
li			
1	Drawing No.		
1	7 OF 10		

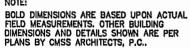


CE COMMON ELEMENT

(LCE) LIMITED COMMON ELEMENT

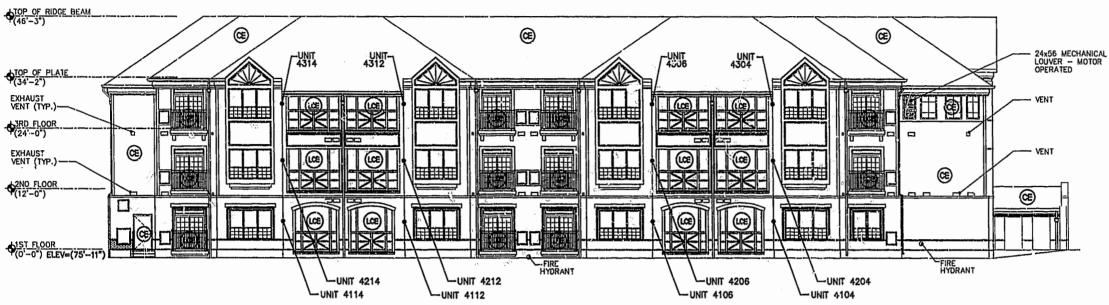

# LEFT SIDE BUILDING ELEVATION (NOT TO SCALE)

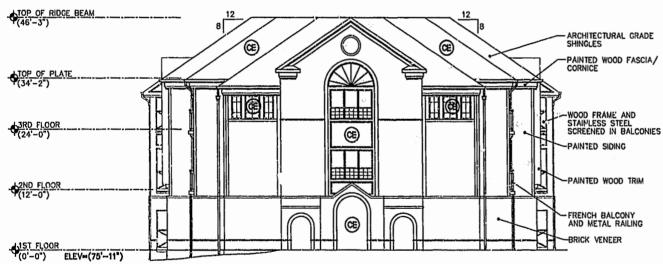

FRONT BUILDING ELEVATION

(NOT TO SCALE)

# NOTES: .

- 1. THE LOWER (HORIZONTAL) BOUNDARY OF EACH UNIT IN BUILDING 4000 SHOWN ON THE PLAT AS LOCATED ON PHASE X IS THE HORIZONTAL PLANE OF THE UPPER SURFACE OF THE FLOOR SLAB OR CONCRETE FLOOR TOPPING OF THE UNIT.
- 2. THE UPPER (HORIZONTAL) BOUNDARY OF EACH OF THE UNITS IN BUILDING 4000 SHOWN ON THE PLAT AS LOCATED ON PHASE X IS THE HORIZONTAL PLANE(S) OF THE LOWER SURFACE OF THE FLOOR JOISTS (OR, IN THE CASE OF THIRD FLOOR UNITS, THE LOWER SURFACE OF THE BOTTOM CHORD OF THE ROOF TRUSSES) CONSTITUTING A PART OF THE CEILING OF THE UNIT.
  - SEE TWELFTH AMENDMENT TO DECLARATION OF CONDOMINIUM OF MANOR CLUB AT FORD'S COLONY, A CONDOMINIUM (PHASE X CONDOMINIUM AGREEMENT) FOR A MORE DETAILED DESCRIPTION.

A.D. SEBERT NO. 00222

# CERTIFICATION FOR PLANS

"THE UNDERSIGNED, A LICENSED LAND SURVEYOR, DOES HEREBY CERTIFY THAT THESE PLANS ARE IN COMPLIANCE WITH VA. CODE ANN. SUBSECTIONS 55-79.58 B AND F. IT BEING UNDERSTOOD THAT SUCH UNITS ARE BEING SUBJECTED TO A TIME-SHARE INSTRUMENT PURSUANT TO VA. CODE ANN. SECTION 55-367 AND THUS VA. CODE ANN. SUBSECTION 55-79.58 D APPLIES, I FURTHER CERTIFY THAT ALL UNITS OR PORTIONS THEREOF DEPICTED HEREON HAVE BEEN SUBSTANTIALLY COMPLETED.

A. D. SEBERT, L.S.

DATE



5248 Olde Towne Road, Suite 1 Williamsburg, Virginia 23188 (757) 253-0040 Fax (757) 220-8994

PLAT OF CONDOMINIUM MANOR CLUB AT FORD'S COLONY PHASE X


EXHIBIT A-J

OWNER/DEVELOPER: MARRIOTT OWNERSHIP RESORTS, INC. JAMES CITY COUNTY POWIATAN DISTRICT VIRGINIA

		ity of Williamsburg & County of James City	
<u> </u>		ircuit Count: This PLAT was recorded or	· ———
		10:46 AWMM. PB 85 PG 4-13	:
<b></b>		OCUMENT # 02000 2823	·+
<del> </del> -	قر	ETSY B. WODLRIDGE, CLERK	•
<del>                                     </del>	(	Sitoy B. Workidge, Dop. Clork	
		( See 1971)	


Designed ADS	Drawn JFS		
Scole	Date		
NOTED	4/11/01		
Project No.			
773	7739-11		
Draw	Drawing No.		
80	8 OF 10		

**CONSULTING ENGINEERS** 

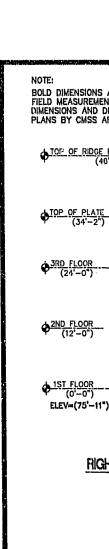


BOLD DIMENSIONS ARE BASED UPON ACTUAL. FIELD MEASUREMENTS. OTHER BUILDING DIMENSIONS AND DETAILS SHOWN ARE PER PLANS BY CMSS ARCHITECTS, P.C.. COMMON ELEMENT

(LCE) LIMITED COMMON ELEMENT

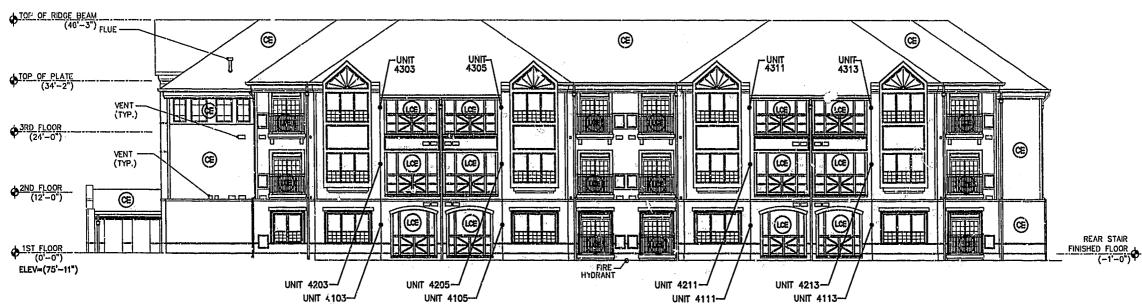

RIGHT SIDE BUILDING ELEVATION

(NOT TO SCALE)

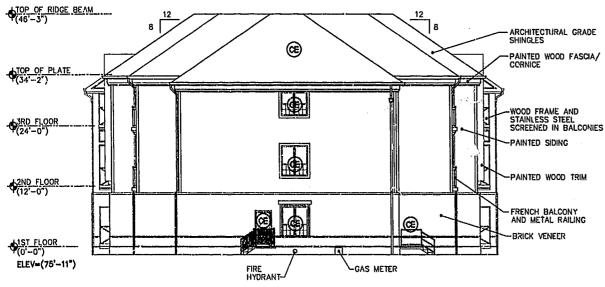

NOTES: +

- 1. THE LOWER (HORIZONTAL) BOUNDARY OF EACH UNIT IN BUILDING 4000 SHOWN ON THE PLAT AS LOCATED ON PHASE X IS THE HORIZONTAL PLANE OF THE UPPER SURFACE OF THE FLOOR SLAB OR CONCRETE FLOOR TOPPING OF THE UNIT.
- 2. THE UPPER (HORIZONTAL) BOUNDARY OF EACH OF THE UNITS IN BUILDING 4000 SHOWN ON THE PLAT AS LOCATED ON PHASE X IS THE HORIZONTAL PLANE(S) OF THE LOWER SURFACE OF THE FLOOR JOISTS (OR, IN THE CASE OF THIRD FLOOR UNITS, THE LOWER SURFACE OF THE BOTTOM CHORD OF THE ROOF TRUSSES) CONSTITUTING A PART OF THE CEILING OF THE UNIT.
  - SEE TWELFTH AMENDMENT TO DECLARATION OF CONDOMINIUM OF MANOR CLUB AT FORD'S COLONY, A CONDOMINIUM (PHASE X CONDOMINIUM AGREEMENT) FOR A MORE DETAILED DESCRIPTION.

CERTIFICATION FOR PLANS

"THE UNDERSIGNED, A LICENSED LAND SURVEYOR, DOES HEREBY CERTIFY THAT THESE PLANS ARE IN COMPLIANCE WITH VA. CODE ANN. SUBSECTIONS 55-79.58 B AND F. IT BEING UNDERSTOOD THAT SUCH UNITS ARE BEING SUBJECTED TO A TIME-SHARE INSTRUMENT PURSUANT TO VA. CODE ANN. SECTION 55-367 AND THUS VA. CODE ANN. SUBSECTION 55-79.58 D APPLIES. I FURTHER CERTIFY THAT ALL UNITS OR PORTIONS THEREOF DEPICTED HEREON HAVE BEEN SUBSTANTIALLY COMPLETED."

A. D. SEBERT, L.S.

4/11/01

EXHIBIT A-3

(NOT TO SCALE)

PLAT OF CONDOMINIUM MANOR CLUB AT FORD'S COLONY PHASE X

OWNER/DEVELOPER: MARRIOTT OWNERSHIP RESORTS, INC.
POWHATAN DISTRICT JAMES CITY COUNTY VIRGINIA

H		City of Williamsburg & County of James City Circuit Court: This PLAT was recorded on	 _
		30 ynu 2002	_
		at 10:48 AM/191 PB 85 PG4-13	 -
		DOCUMENT # 02000823	 _
		Roby Whatridge Hop. Clork	 
No.	DA1E	REVISION / COMMENT / NOTE	 Γ

	-	7 Marie Company of the Control of th	
	Designed	Drawn	
	ADS	JFS	
1	Scale	Date	
	NOTED	4/11/01	
	Project No. 7739–11		
ı			
	Drawing No.		
	9 OF 10		

A.D. SEBERT


CONSULTING ENGINEERS

5248 Olde Towne Road, Sulte 1 Williamsburg, Virginia 23188 (757) 253-0040 Fax (757) 220-8994

REAR BUILDING ELEVATION

T FORD'S COLONY
PHASE X
R: MARRIOTT OWNERSHIP RESORTS, INC.

BOLD DIMENSIONS ARE BASEO UPON ACTUAL FIELD MEASUREMENTS, OTHER BUILDING DIMENSIONS AND DETAILS SHOWN ARE PER PLANS BY CMSS ARCHITECTS, P.C.

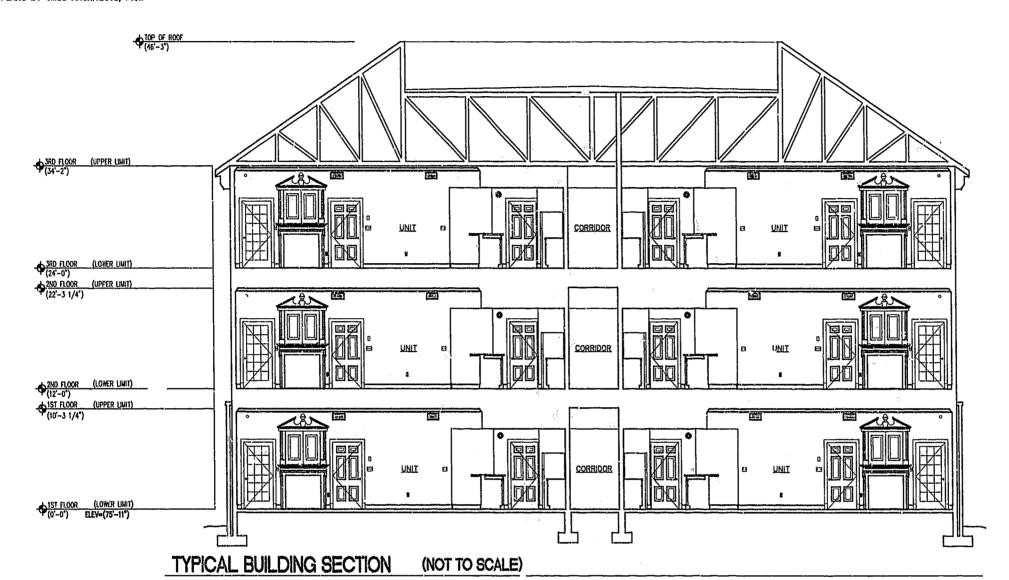

- NOTES: \*

  1. THE LOWER (HORIZONTAL) BOUNDARY OF EACH UNIT IN BUILDING 4000 SHOWN ON THE PLAT AS LOCATED ON PHASE X IS THE HORIZONTAL PLANE OF THE UPPER SURFACE OF THE FLOOR SLAB OR CONCRETE FLOOR TOPPING OF THE UNIT.


  2. THE UPPER (HORIZONTAL) BOUNDARY OF EACH OF THE UNITS IN BUILDING 4000 SHOWN ON THE PLAT AS LOCATED ON PHASE X IS THE HORIZONTAL PLANE(S) OF THE LOWER SURFACE OF THE FLOOR JOISTS (OR, IN THE CASE OF THIRD FLOOR UNITS, THE LOWER SURFACE OF THE BOTTOM CHORD OF THE ROOF TRUSSES) CONSTITUTING A PART OF THE CEILING OF THE UNIT.
  - \* SEE TWELFTH AMENDMENT TO DECLARATION OF CONDOMINIUM OF MANOR CLUB AT FORD'S COLONY, A CONDOMINIUM (PHASE X CONDOMINIUM AGREEMENT)
    FOR A MORE DETAILED DESCRIPTION.



# CERTIFICATION FOR PLANS

"THE UNDERSIGNED, A LICENSED LAND SURVEYOR, DOES HEREBY CERTIFY THAT THESE PLANS ARE IN COMPLIANCE WITH VA. CODE ANN. SUBSECTIONS 55-79.58 B AND F. IT BEING UNDERSTOOD THAT SUCH UNITS ARE BEING SUBJECTED TO A TIME-SHARE INSTRUMENT PURSUANT TO VA. CODE ANN. SECTION 55-367 AND THUS VA. CODE ANN. SUBSECTION 55-79.58 D APPLIES, I FURTHER CERTIFY THAT ALL UNITS OR PORTIONS THEREOF DEPICTED HEREON HAVE BEEN SUBSTANTIALLY COMPLETED."



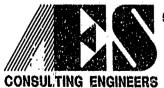

5248 Olde Towne Road, Suite 1 Williamsburg, Virginia 23188 (757) 253-0040 Fax (757) 220-8994

EXHIBIT A-3 PLAT OF CONDOMINIUM MANOR CLUB AT FORD'S COLONY PHASE X

OWNER/DEVELOPER: MARRIOTT OWNERSHIP RESORTS, INC. POWHATAN DISTRICT JAMES CITY COUNTY

	City of Williamsburg & County of James City Circuit Court: This PLAT was recorded on  at 16:48 AMPES: PB 95 PG 4-13 DOCUMENT# 3000883 DOCUMENT# 3000883 DETSY B, WOOLRIDGIS CLERK  CAPITAL ALL CAPITAL AREAS. Bop. Clork
No. DATE	REVISION / COMMENT / NOTE

	Designed	Drawn	
7	ADS	JFS	
-1	Scale	Date	
-	NOTED	4/11/01	
1	Project No.		
-1	7738-11		
	Drawing No.		
Y	10 OF 10		
_	Harriston St. serandina.		