
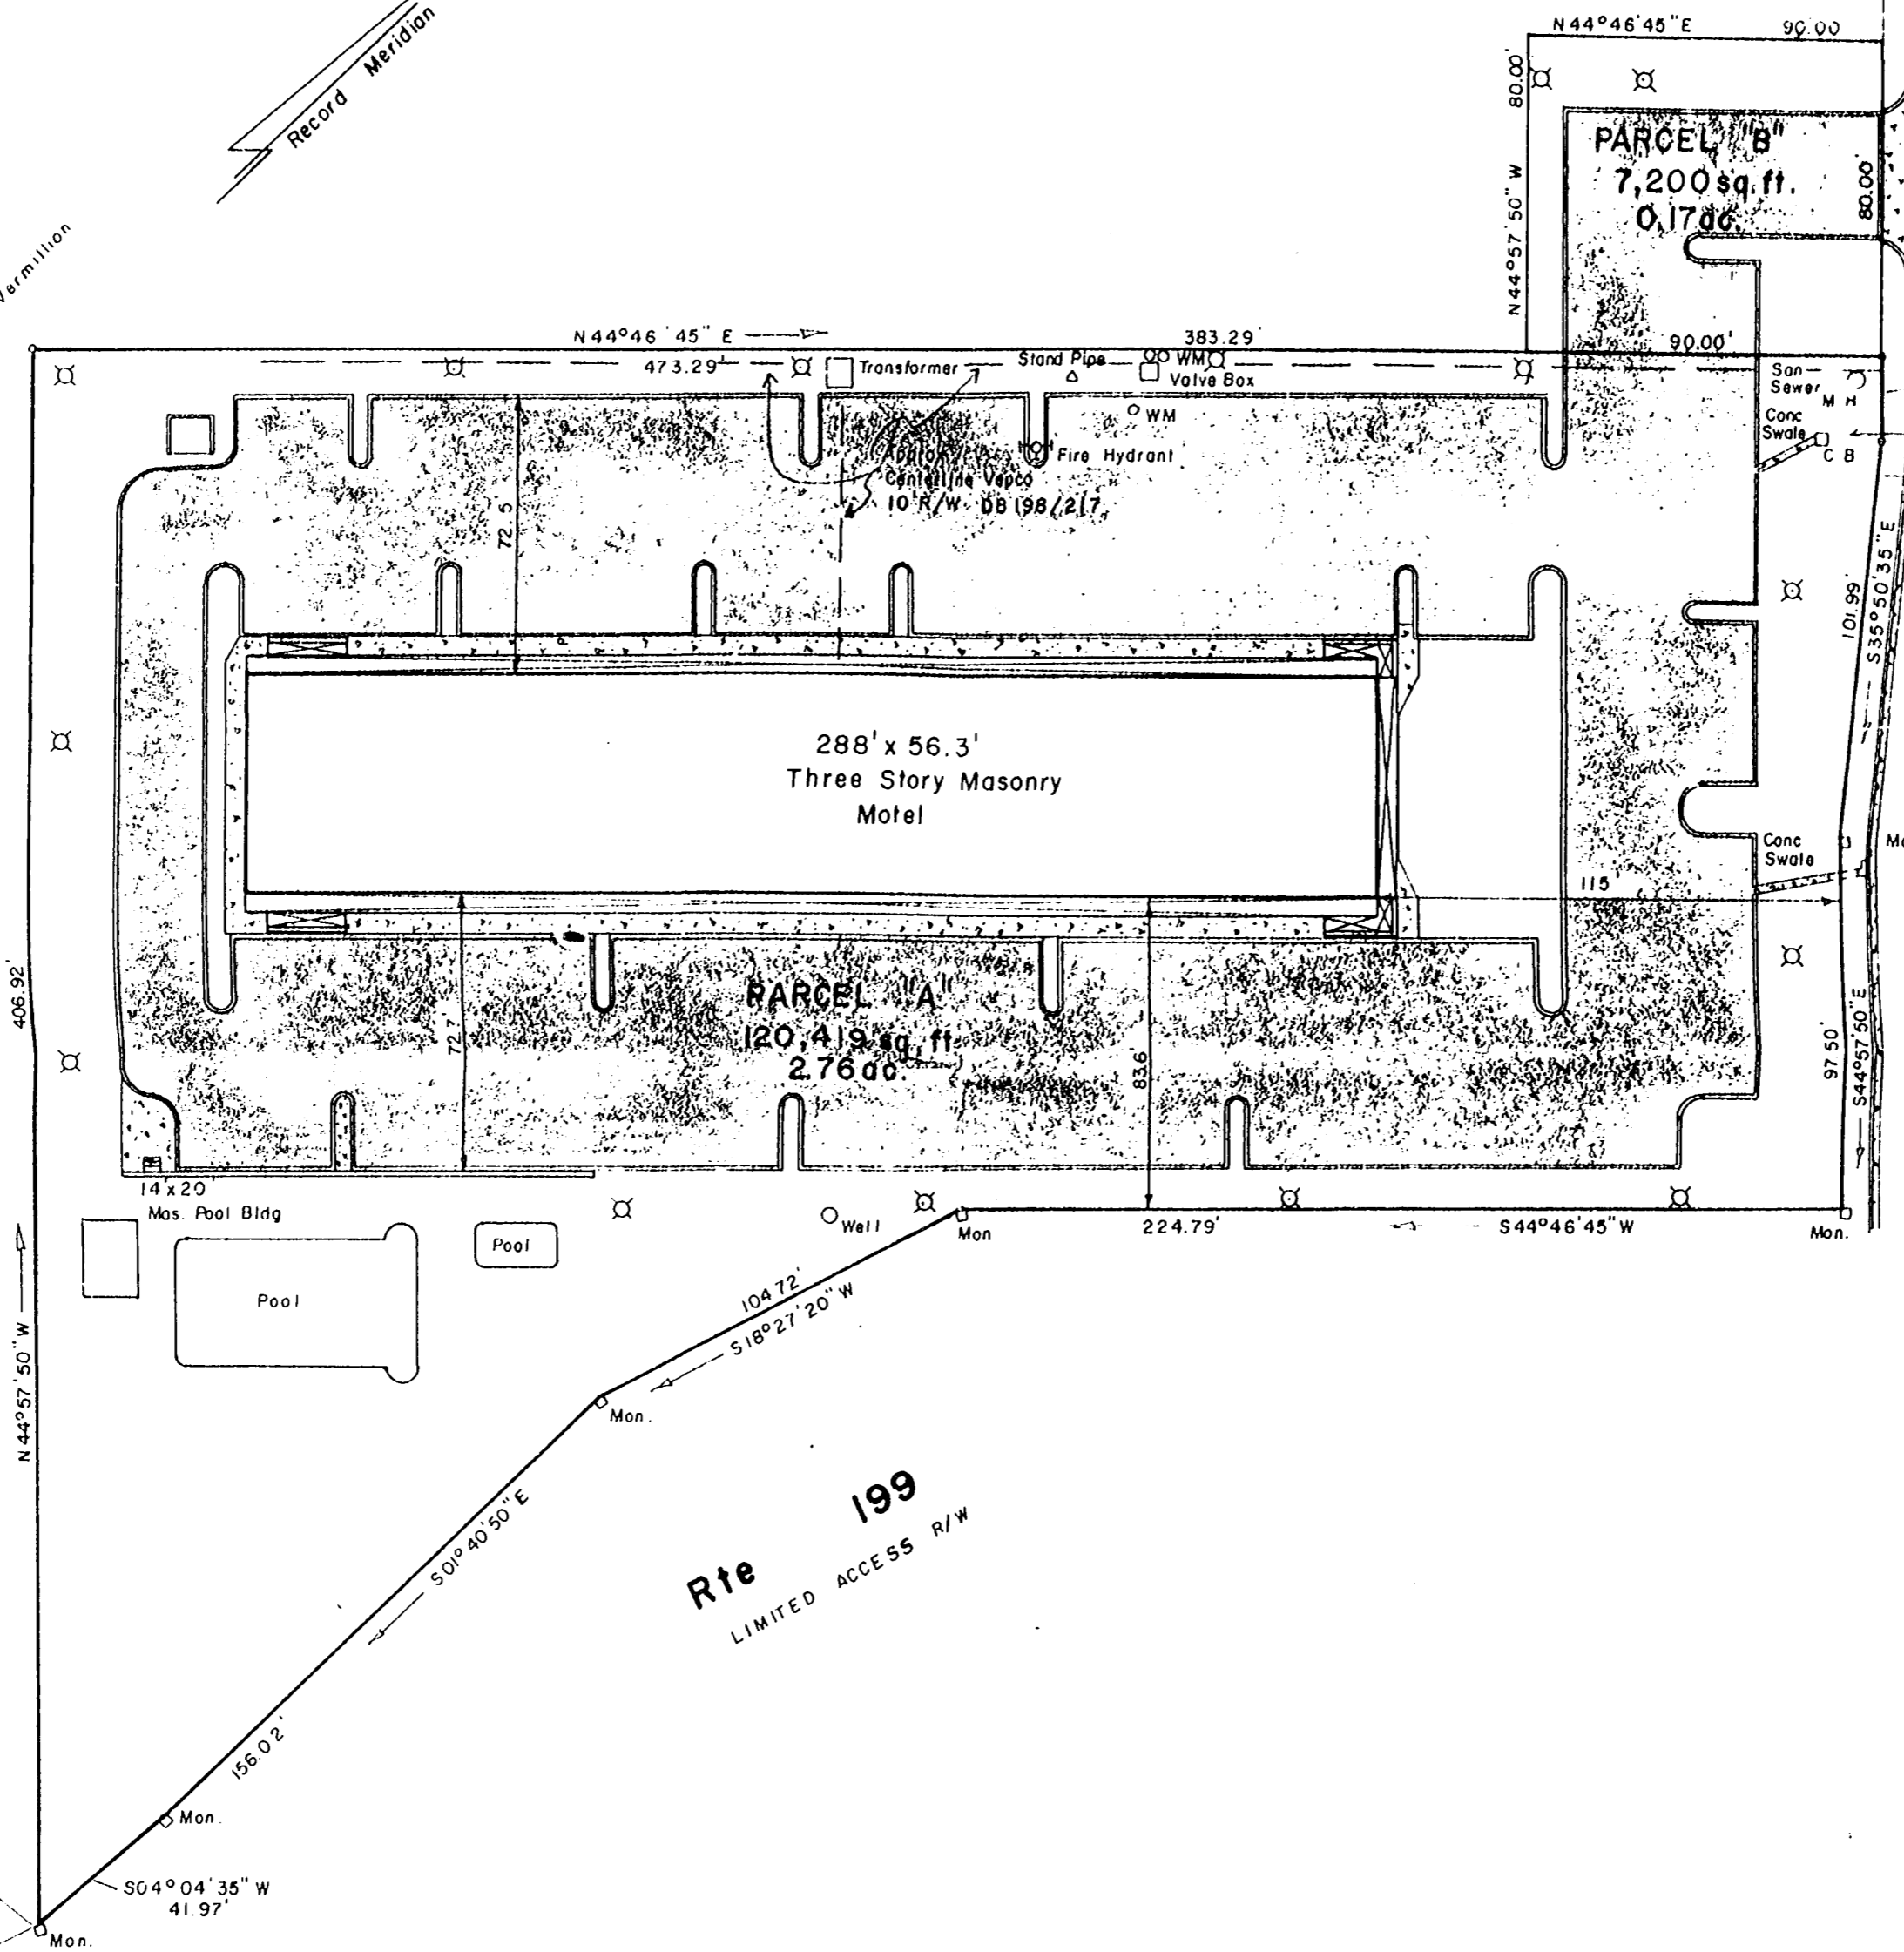


Other Lnds. T. R. Vermillion

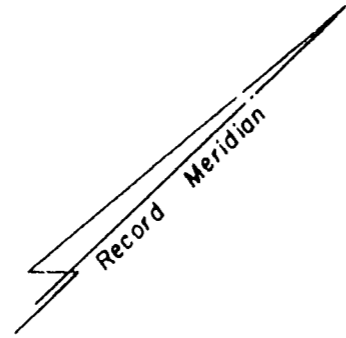

S44°57'50"E
21.89'

V.O.H.&T. Drop Inlet
and maintenance easement
as described in DB134/564
at this location

U.S. Rte 60

Begin Rte 60 Limited
Access R/W
DB134/564
DB172/421

Rte 199
LIMITED ACCESS R/W

**AS BUILT SURVEY
BEST WESTERN MOTEL**

T. R. Vermillion, Owner
James City County, Virginia

1" = 40' Mar. 26, 1980



11:58 A.M.
Recorded 2nd day of April, 1980
in
D. B. No. 202 pages 257
Julietta C. Clarke Clerk

EVANS SURVEYING CO., P.C.
WILLIAMSBURG, VA.