




AES is a professional corporation  
 1781 Jamieson Road, Williamsburg, VA 23185  
 804-233-0040  
 Architecture, Engineering, Surveying, Planning

**OUTLETS LTD.**  
 COMPANY STORES CAPITAL CORP.  
**PARCEL 4 15.9665 ACRES**  
 FOWHATAN DISTRICT  
 JAMES CITY COUNTY, VIRGINIA



NO.	DATE	DESCRIPTION
1	1/21/83	AS BUILT SURVEY
2	1/21/83	AS BUILT SURVEY
3	1/21/83	AS BUILT SURVEY
4	1/21/83	AS BUILT SURVEY
5	1/21/83	AS BUILT SURVEY
6	1/21/83	AS BUILT SURVEY

Designed by: [Signature]  
 Drawn by: [Signature]  
 Checked by: [Signature]  
 Project No. 8148  
**PLAT**

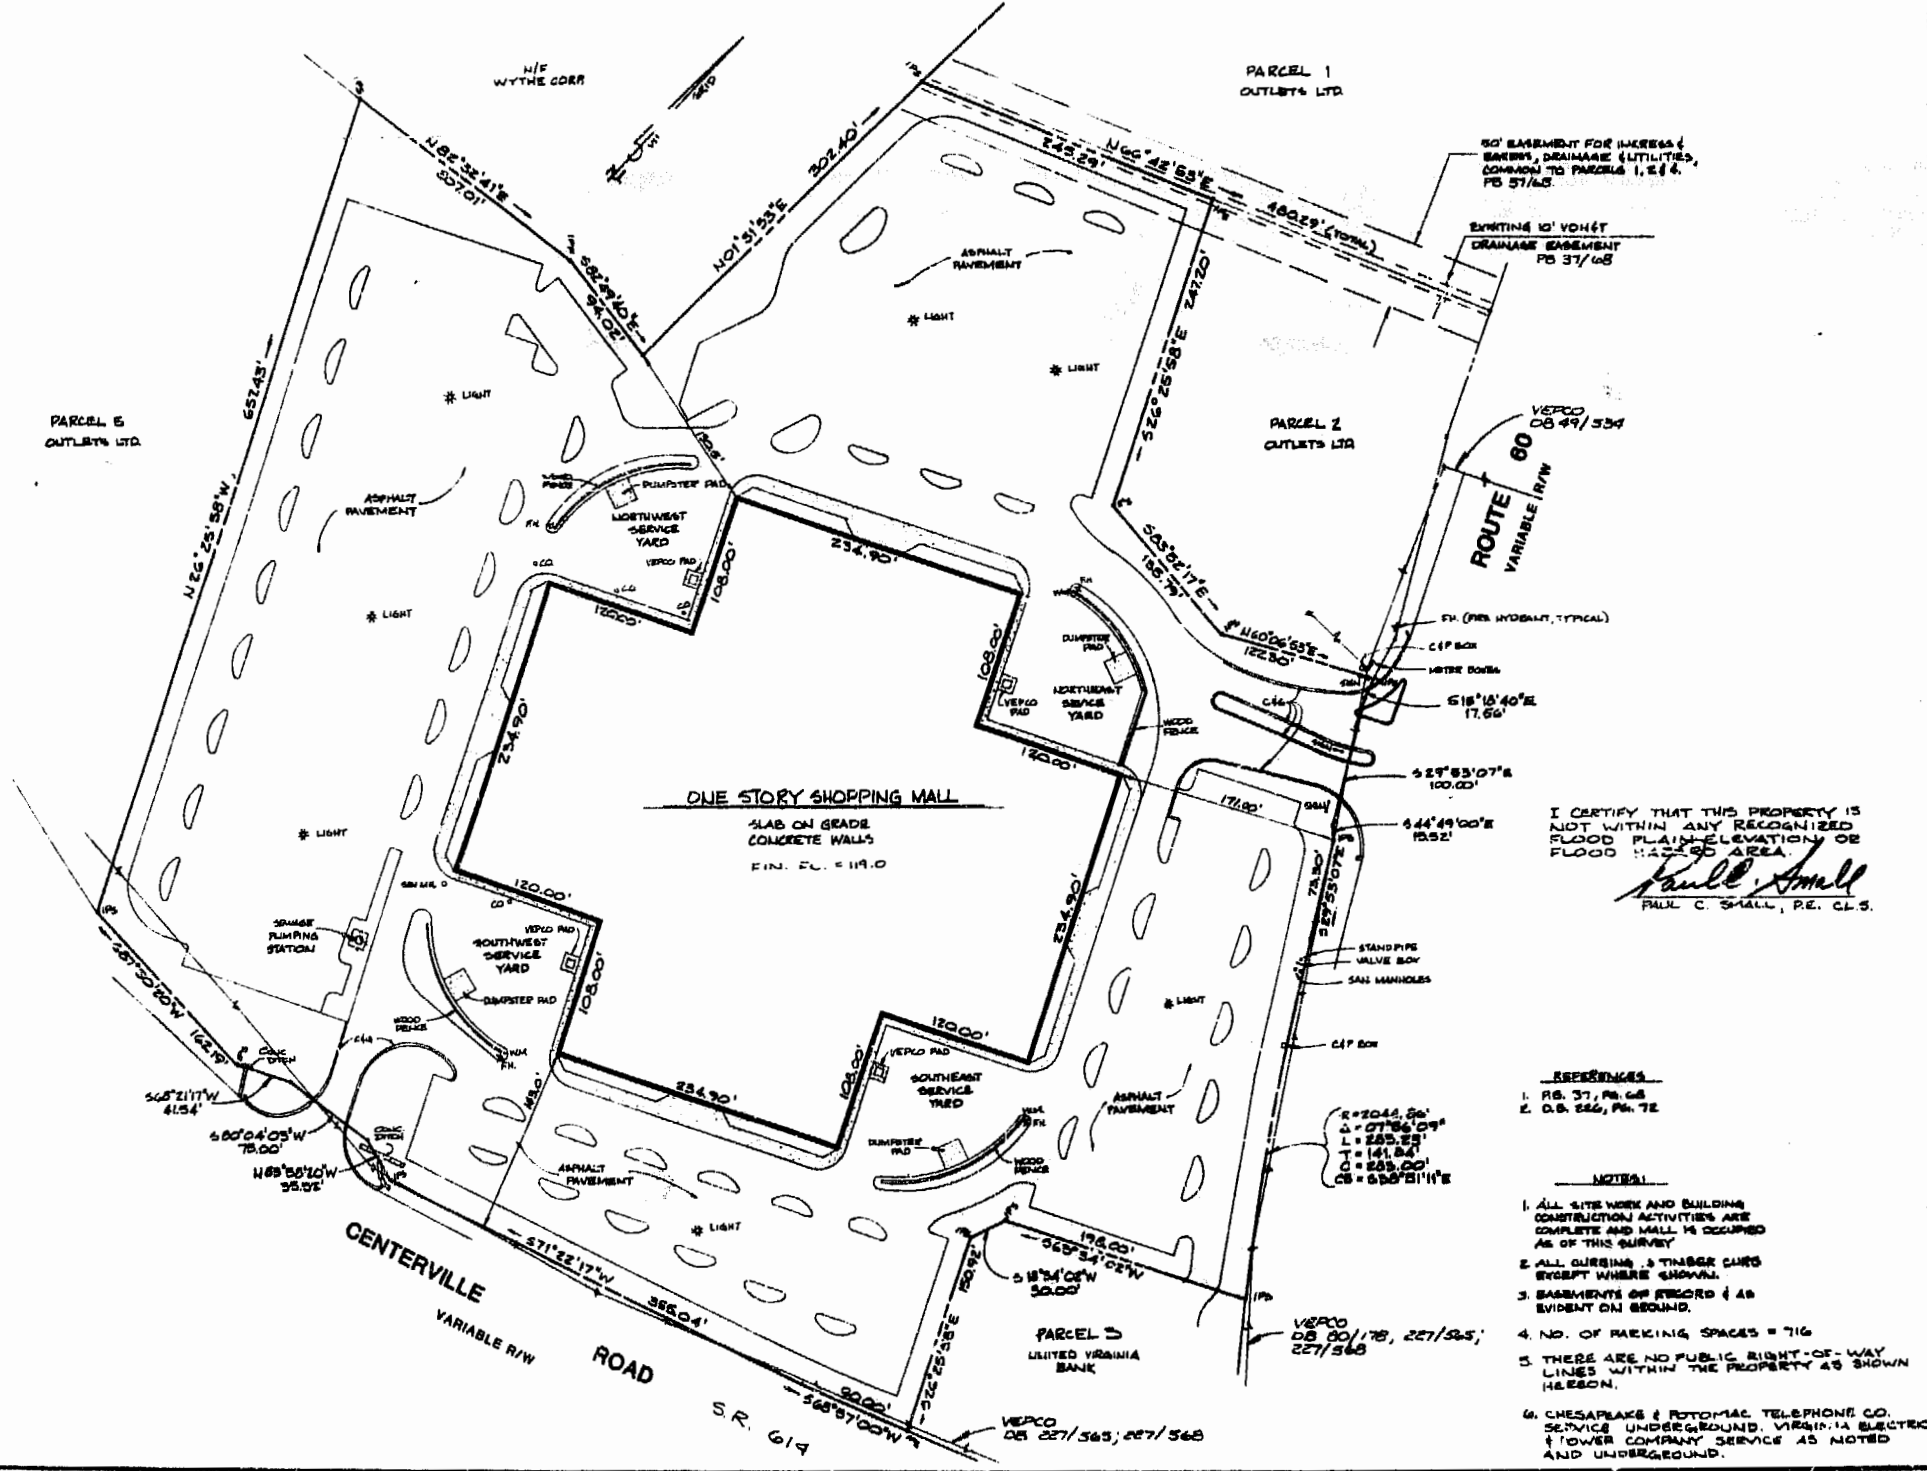

I CERTIFY THAT THIS PROPERTY IS NOT WITHIN ANY RECOGNIZED FLOOD PLAIN ELEVATION OR FLOOD HAZARD AREA.  
*Paul C. Small*  
 PAUL C. SMALL, P.E., C.E.S.

- REFERENCES**
- PG. 37, PG. 48
  - D.B. 226, PG. 72

- NOTES**
- ALL SITE WORK AND BUILDING CONSTRUCTION ACTIVITIES ARE COMPLETE AND MALL IS OCCUPIED AS OF THIS SURVEY.
  - ALL CURBING & TIMBER CURB EXCEPT WHERE SHOWN.
  - BASEMENTS OF RECORD & AS EVIDENT ON GROUND.
  - NO. OF PARKING SPACES = 716
  - THERE ARE NO PUBLIC RIGHT-OF-WAY LINES WITHIN THE PROPERTY AS SHOWN HEREON.
  - CHESAPEAKE & POTOMAC TELEPHONE CO. SERVICE UNDERGROUND. VIRGINIA ELECTRIC & POWER COMPANY SERVICE AS NOTED AND UNDERGROUND.

Recorded 1<sup>st</sup> day of July, 1983  
 D. B. No. 234 pages 735  
*Helene S. Ward* Clerk