

**СИМВОЛ / СИМВОЛЫ ДРУЗЕЙ, КОТОРЫЕ
ДОЛЖНЫ БЫТЬ СДЕЛАНЫ**



~~MANAGERS 10-10-11~~

— 1 —

A TITLE REPORT WAS FURNISHED BY CANTON
TITLE INSURANCE COMPANY RECENTLY WHICH
WAS GO-NO-RECORDS EFFECTIVE MAY 31, 1967. THEREFORE,
THIS PLAT MAY NOT INSURE ALL OWNERSHIP TRANSFERS
ON THIS PROPERTY FROM MAY 31, 1967.

۱۰۰

BOOK 41 PAGE 58

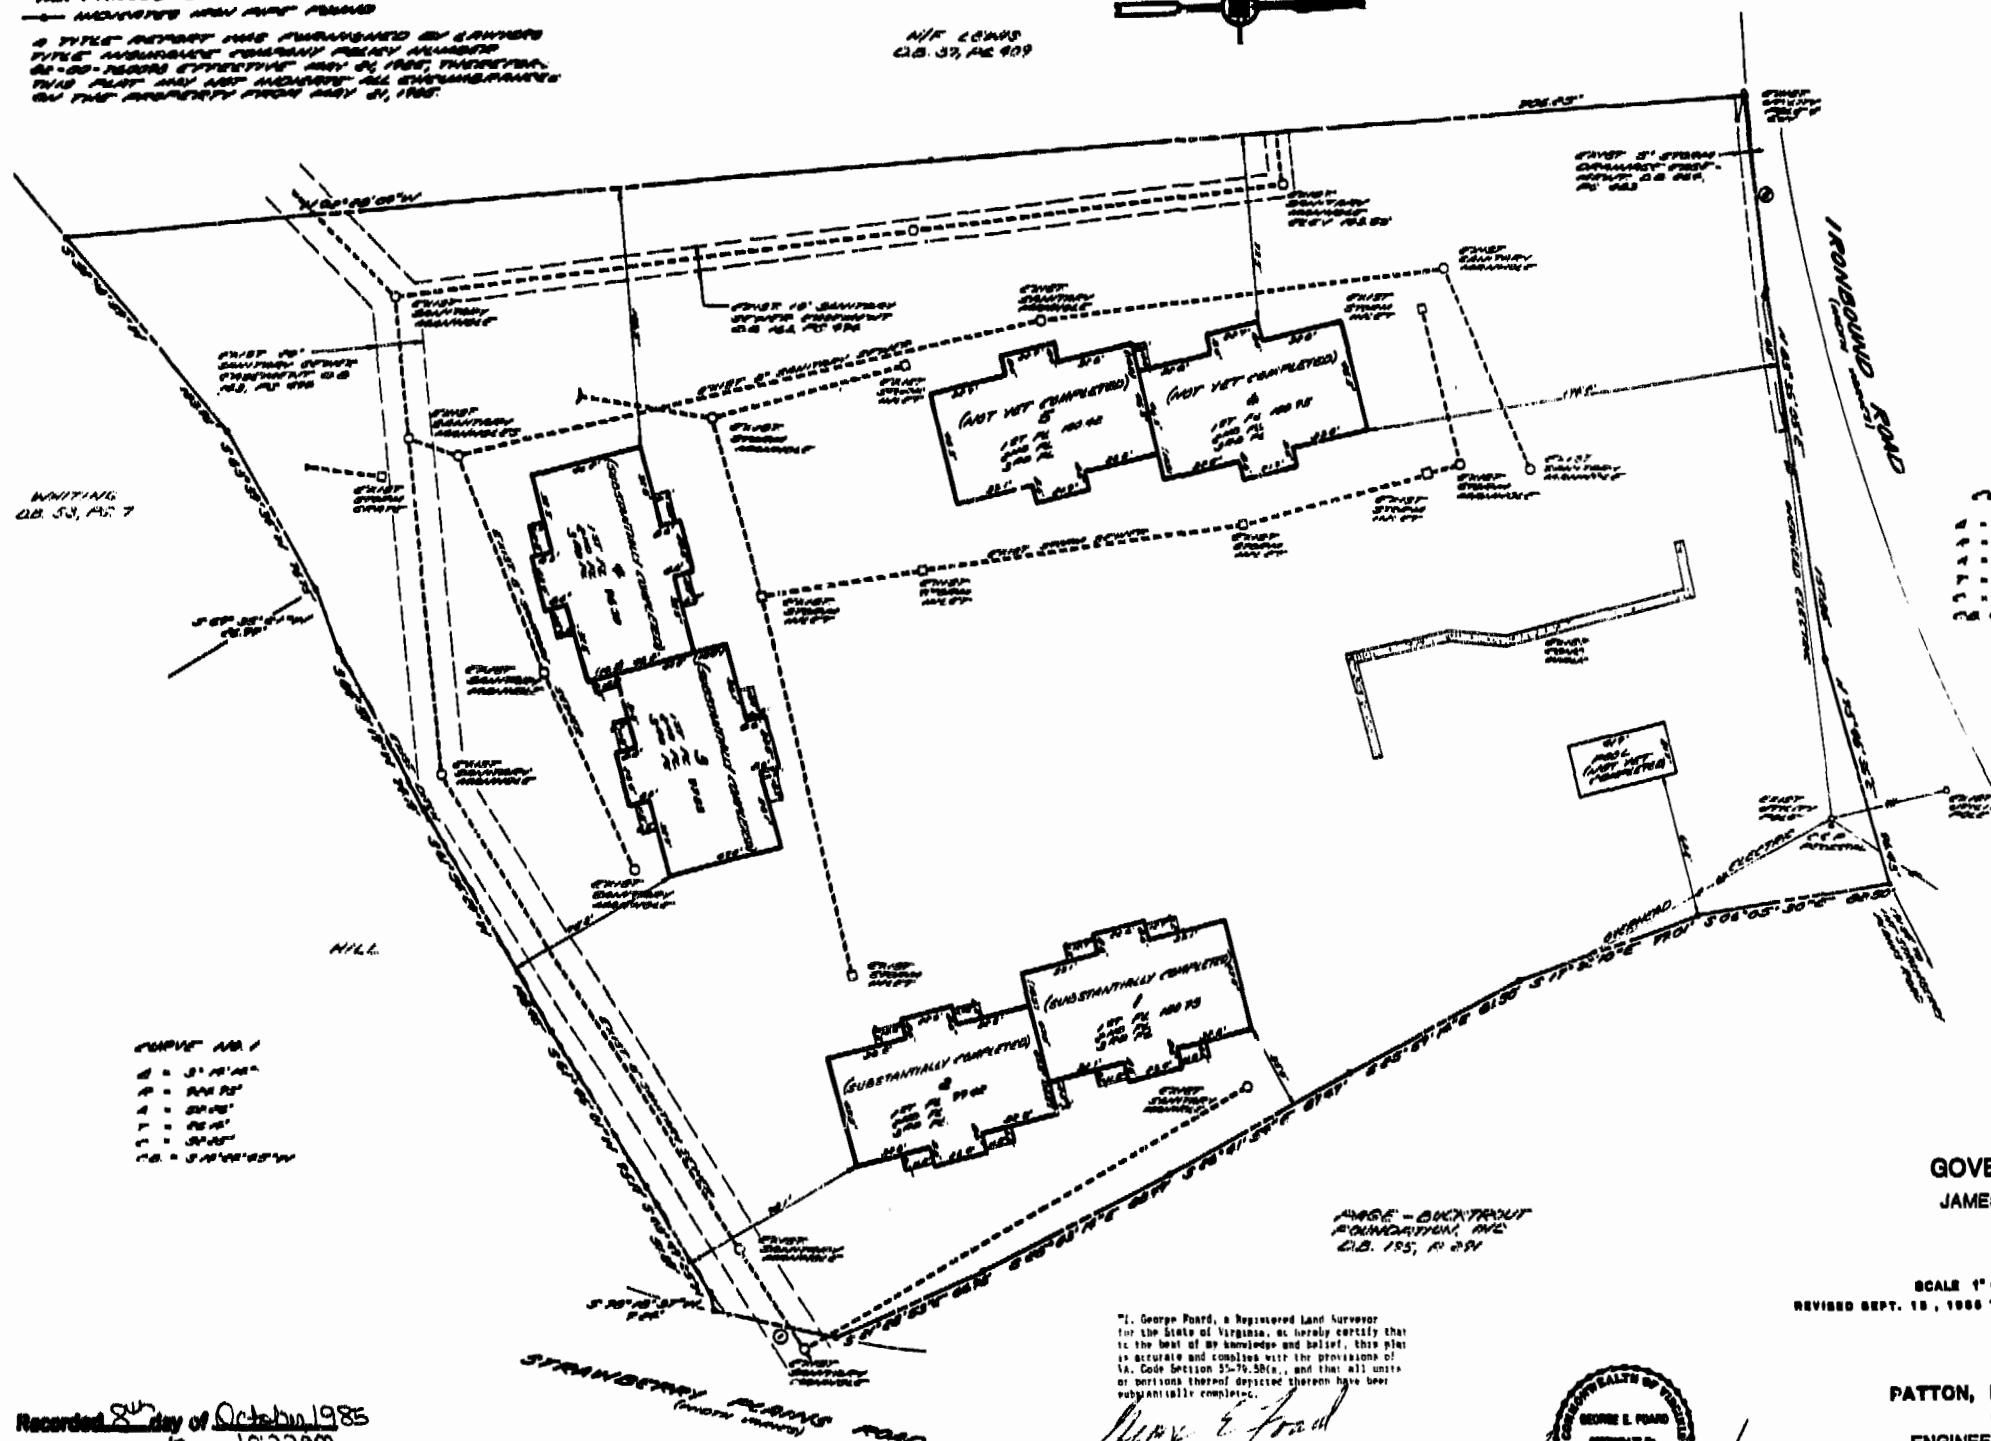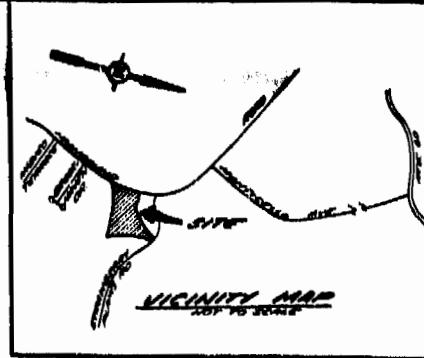

~~11-10-5105~~ page 1610

Saline Strand Chart

"I, George Board, a Registered Land Surveyor for the State of Virginia, at hereby certify that to the best of my knowledge and belief, this plan is accurate and complies with the provisions of Va. Code Section 55-76.58(a), and that all units or portions thereof depicted thereon have been substantially completed.

See attached plan "Sheet C-1, Dimensional Layout for Governor's Square project for the intended location and dimensions of parking and roadway improvements not yet substantially completed.



SCALE 1" = 55' DATE: JULY 16, 1985
REVISED SEPT. 18, 1985 TO SHOW UNITS 1 THROUGH 4 SUBSTANTIALLY COMPLETED

DATED: JULY 19, 1995

**IMPROVEMENT SURVEY
ON THE LAND OF**

GOVERNOR'S SQUARE INC.

JAMES CITY COUNTY, VIRGINIA

PREPARED BY
PATTON, HARRIS, RUST & ASSOCIATES
a professional corporation
ENGINEERS • SURVEYORS • PLANNERS
LANDSCAPE ARCHITECTS
BRIDGEWATER, VIRGINIA

Exhibit C

